

WATER SERVICE RECORD

Name A. J. Comeau

Service No. 106

Address 7 Philip Rd.

Location Lexington

~~REPAIR EXPENSE~~ - New Service

am 7-13-53

Date	Material	Amount	Total	Date	Amount
6/5/53	Labor	4 75		5-21-53	60 00
6/8/53	Labor	6 25		7-13-53	1 27
		11 00			58 73
	10% overhead	1 10	12 10		
	68' - 3/4" Copper Tubing .37		25 16	1-1/2 straight tail piece	50
	1-3/4" C x 1/2 I.W.H. STOP & WASTE		4 00	1-1/2 offset tail piece	50
	1-3/4" C x 3/4" C. Union (3 parts)		1 72		1 00
	2 Hrs. Littlefield Shovel @7.50		15 00	SERVICE WAS IN TO CURB:	
	1 Hr. Trucking		75		
			58 73		


DATE _____

TOWN OF LEXINGTON — BOARD OF PUBLIC WORKS

WATER DIVISION

Sketch of Service Here

W.S. Form # 7

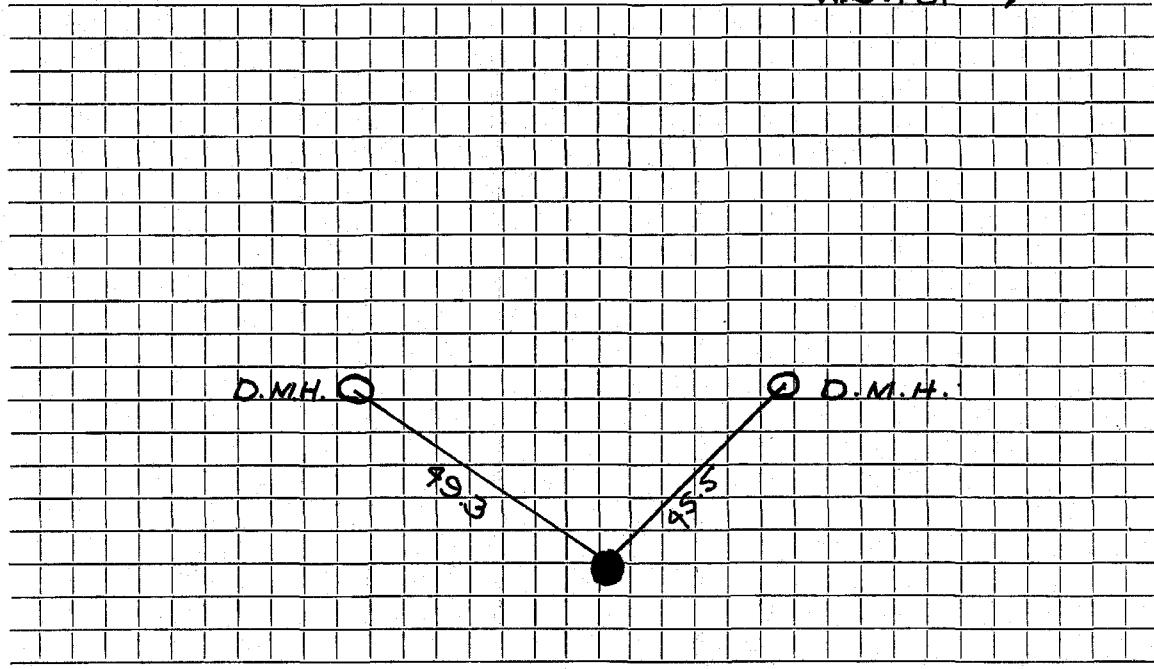

Connection made in Street. Work completed

Remarks:
.....
.....