

## WATER SERVICE RECORD

Name Charles DiGiovanni

Service No. 127

Address 7 Phinney Road

Location Lot 379 Sta. 2 / 42 (5' Deep)

~~REPAIRS~~ - New Service

WO # 8271


MAR 23 1964

Date	Material	Amount	Total	Date		Amount
11-5-63	Labor	4 73		10-28-63	Deposit	100 00
	10% O.H.	47	5 20	3-23-64	Returned	62 73
53'	3/4" Copper Tubing @ .42		22 26			32 27
1	3/4" C Corp Cock		4 91			
1	Box & Rod		4 90	10/18/61	Labor	2 04
			37 27		20' 3/4" Copper Tubing @ .42	8 40
					1 3/4" C Curb Cock	6 28
					1 3/4" C Corp Cock	4 91
					1 Bow & Rod	4 90
						26 53
				11-5-63	1 1/2 Straight Tailpiece	50
					1 1/2 Offset Tailpiece	50
						27 53

TOWN OF LEXINGTON — BOARD OF PUBLIC WORKS

WATER DIVISION

Sketch of Service Here

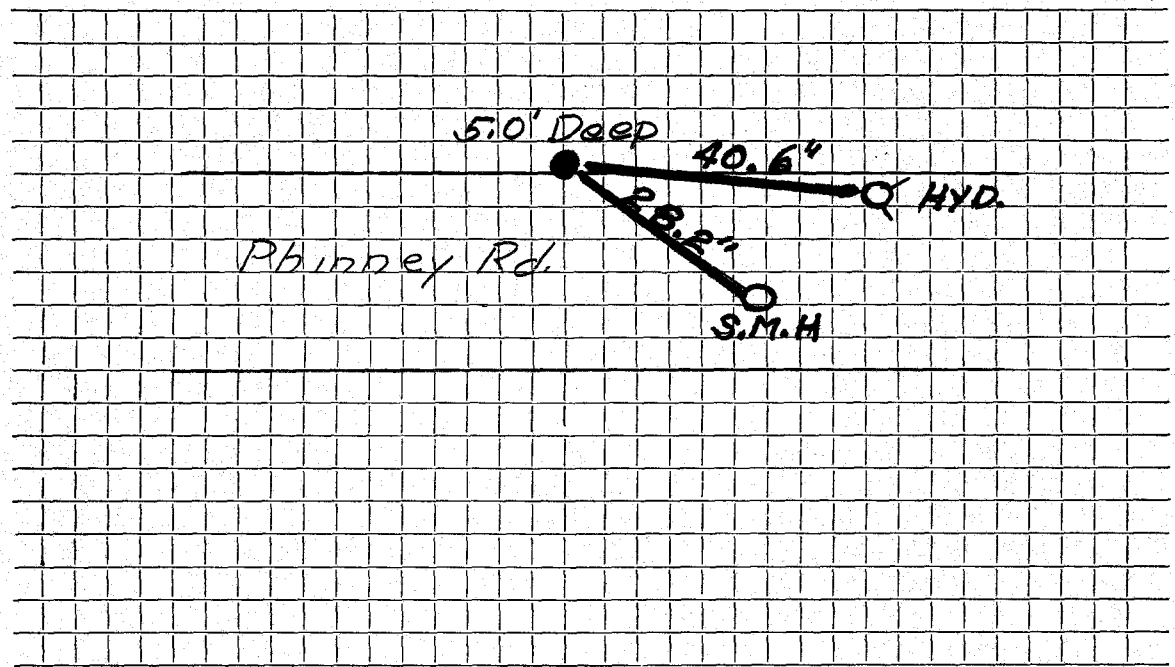

Connection made in ..... Street. Work completed .....

Remarks: .....  
.....  
.....