

WATER SERVICE RECORD

Name Gladys Colwell

Service No. 38

Address 8 Phinney Road

Location

~~Repair~~ ~~Renewal~~ New Service

WO# 8695


JUN 29 1964

Date	Material	Amount	Total	Date		Amount
5/1/64	Labor	2 65		4-28-64	Deposit	100 00
	10% O.H.	27	2 92	6-29-64	Returned	70 33
	49' 3/4" Copper Tubing		20 58			29 67
	1 3/4" Cx 1/2 I.W.H. Stop & Waste		6 17			
			29 67	5/1/64	1 1/2 Straight Tailpiece	50
					1 1/2 Offset Tailpiece	50
						1 00

TOWN OF LEXINGTON — BOARD OF PUBLIC WORKS

WATER DIVISION

Sketch of Service Here

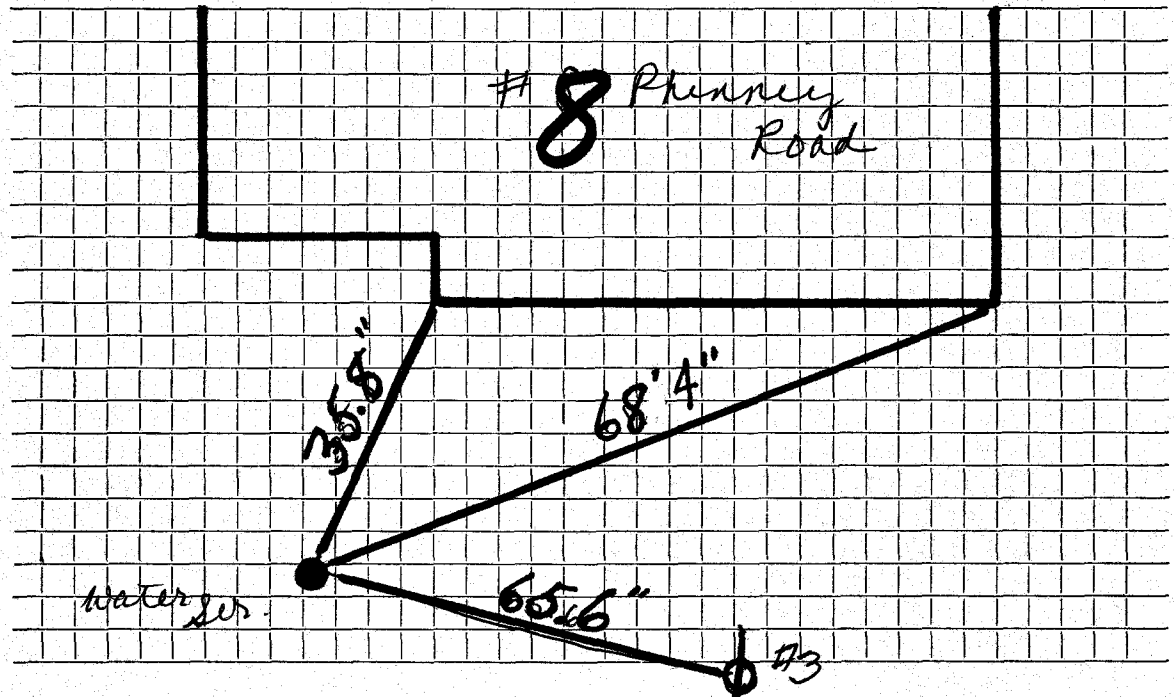

Connection made in Street. Work completed

Remarks:
.....
.....