

Name Leeland Const. Company

Service No. 241

Address 13 Pine Knoll Road

Lexington, Mass.

Location

2564

Kind of Pipe

Size

Size of Main

~~Repair~~ ~~Renewal~~ - New Service

Location

Date	Material	Amount	Total	Date	Location	Amount
Oct. 16, '48	Labor	16 73	16 73	Oct 11. '48	Deported	35 00
	10% Overhead		1 67	Dec 27 '48	Card	8 50
	40'-3/4" Copper Tubing @ .255		10 20		Non-charge	38 50
	1-3/4" C x 1/2" I.W.H. S & W		3 15	Oct, 15, '48	Labor	25 76
	1 hr. Trucking		75		11-3/4" Copper Tubing @ .255	2 81
	Patching 6 x 3		6 00		1-3/4" C. Corp.-cock	3 00
			38 50		1-3/4" C x 3/4" C. Curb-cock	3 68
					1-Box & Rod	3 55
					1-1/2" Straight Tail Piece	30
					1-1/2" Offset Tail Piece	30
					1 hr. Trucking	75
	Labor					40 15

Hadley Press, Inc., Lexington

TOWN OF LEXINGTON—BOARD OF PUBLIC WORKS

WATER DIVISION

The undersigned applies for a supply of water at No. _____ St. and hereby agrees to comply with the rules and regulations as now, or at any future time, established by the Board of Selectmen.

Am't. of Estimate \$ _____


Owner _____

Am't. Paid \$ _____

Address _____

Builder _____

Sketch of Service Here

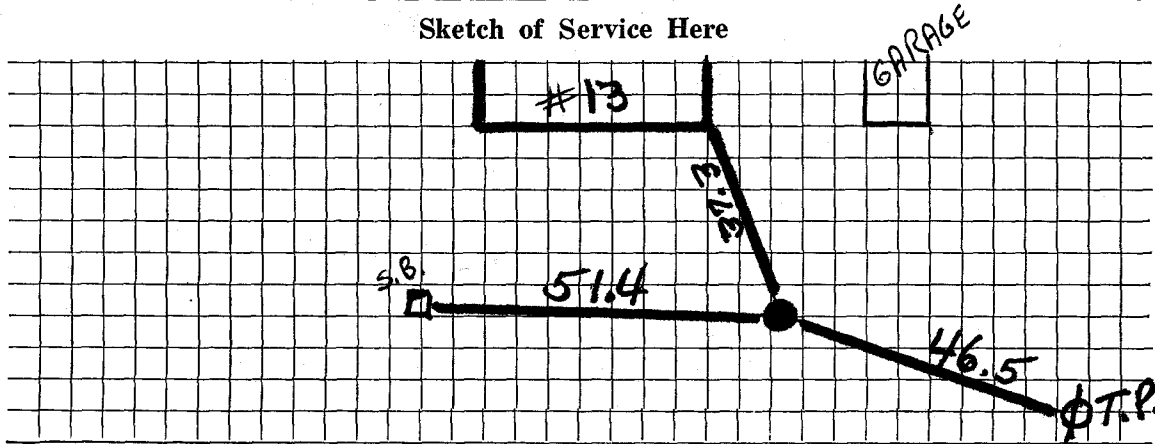

Connection made in _____ Street.

Work completed _____ 19

Remarks: