


Water Service Tie Card
TOWN OF LEXINGTON
 MASSACHUSETTS

14 Pineknoll Rd

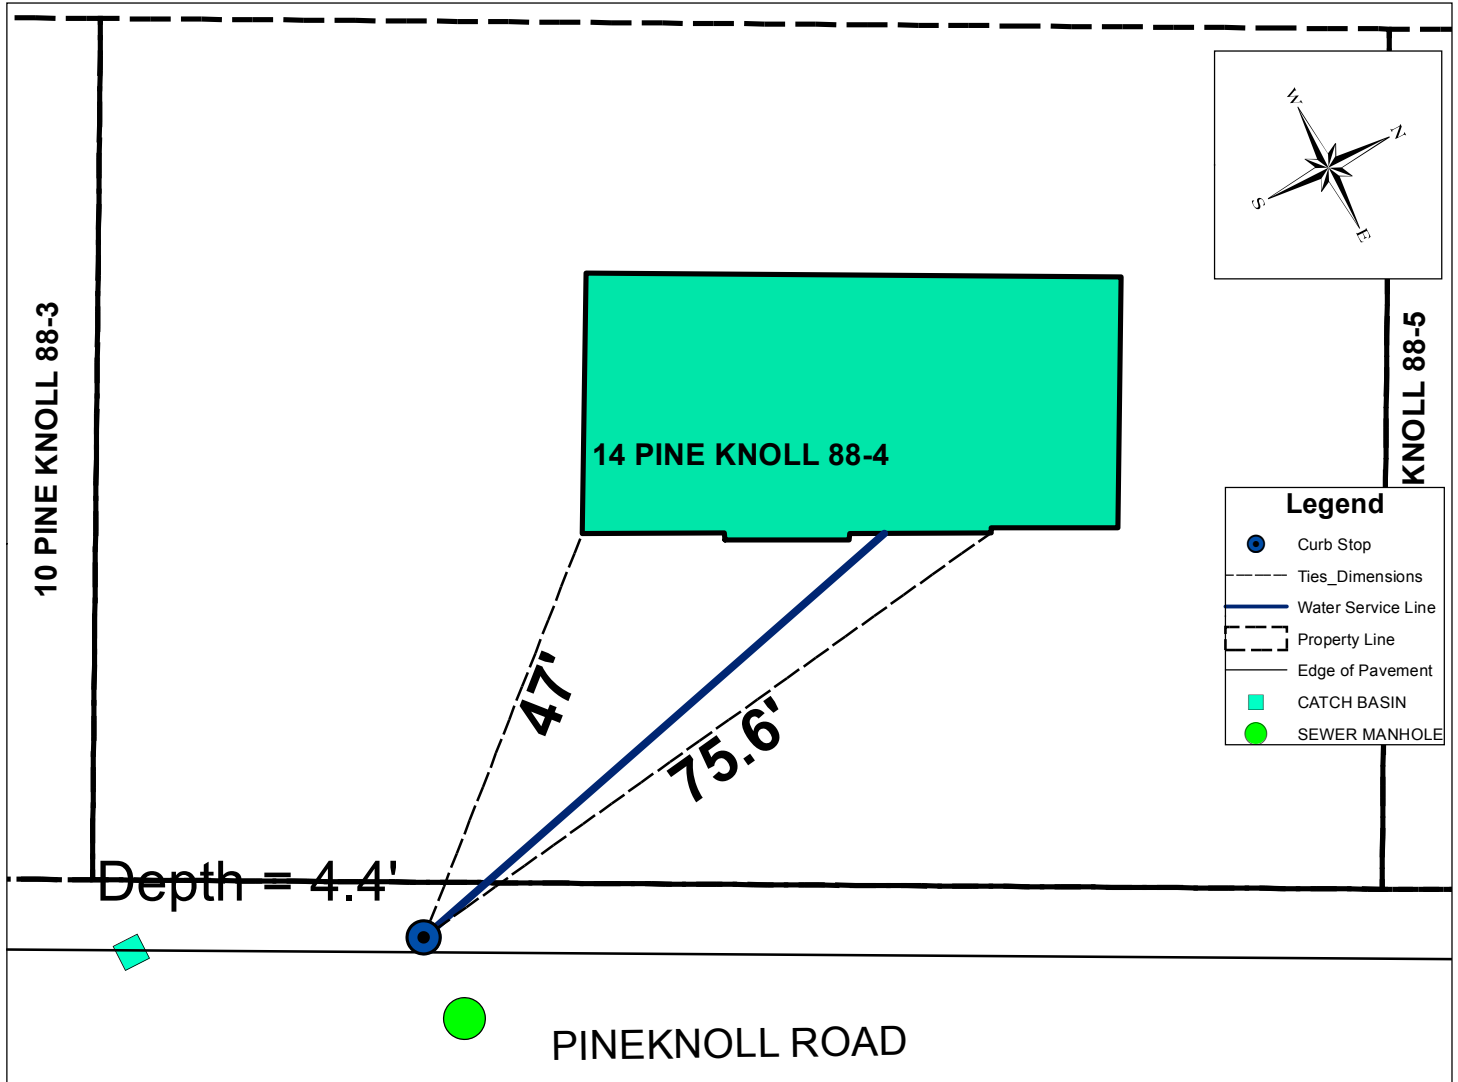

| Address | Map and Lot | Permit Number | Contractor Name | Inspector |
|------------------------|-------------------------------|----------------|---------------------------|-----------|
| 14 Pineknoll Rd | 88-4 | 6107 | McLaughlin, James M. Inc. | msprague |
| Date | Material | Depth of Cover | Amount | |
| 4/21/2015 | 3/4" Copper type "k" | 4.4 ft | 1 ft | |
| | 3/4" to 1" fitting | 4.4 ft | 1 | |
| | 1" Copper type "k" | 4.4 ft | 1 ft | |
| | 1" Curb Valve and Buffalo Box | 4.4 ft | 1 | |
| | 1" Copper type "k" | | 65 ft | |
| Type of work completed | | | | |

New 1" water service to house from curb stop. New house on lot old house removed.