

WATER SERVICE RECORD

Name Donald Cruwys

Service No. 206

Address 15 Pine Knoll Road

Location

~~Repaired~~ New Service


Comm 10-24-60

Date	Material	Amount	Total	Date	Amount
9-26-60	Labor	35.04		9-25-60	Deposit 150.00
	10% O.H.	3.50	38.54	10-24-60	Returned 61.09
60'	3/4" Copper tubing @.42		25.20		88.91
1	3/4" C x 1/2 I.W.H. Stop & Waste		6.17		NON CHARGE
2	hrs. Town Shovel @6.50		13.00	9-26-60	Labor 3.88
2	hrs. Trucking @3.00		6.00		10' 3/4" Copper tubing @.42 4.20
			88.91		1 3/4" C Curb Cock 6.28
					1 3/4" C Corp Cock 4.91
					1 Box & Rod 4.90
					1 1/2 Straight tailpiece .50
					1 1/2 Offset tailpiece .50
					1/2 hr. Town Shovel @6.5 3.25
					28.42

DATE _____

TOWN OF LEXINGTON — BOARD OF PUBLIC WORKS
WATER DIVISION

Sketch of Service Here

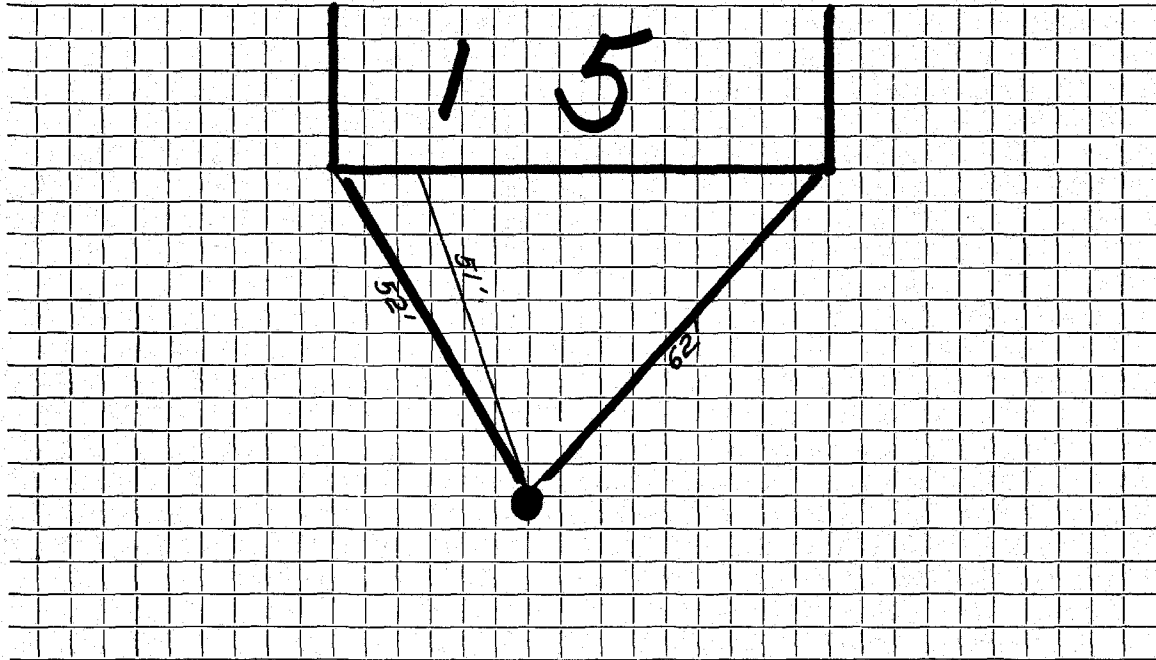

Connection made in Street. Work completed

Remarks:
.....
.....