

#5294

## WATER SERVICE RECORD

Name Donald L. Cruwys

Service No. 50

Address 17 Pine Knoll Road

Location

~~Repair~~ ~~XXXXXX~~ New Service


Comm 6-19-61

Date	Material	Amount	Total	Date	Amount
5-10-61	Labor	17.39		4-24-61	Deposit 150.00
	10% O.H.	1.74	19.13	6-17-61	Retard 73.88
73'	3/4" Copper Tubing @.42		30.66		NON CHARGE 76.12
1	3/4" Cx 1/2 I.W.H. Stop & Waste		6.17	5-10-61	Labor 2.14
1	3/4" C3 part Union		2.41	9'	3/4" Copper @/42 3.78
	5 x 3 Patch		5.00	1	3/4" C Corp. Cock 4.91
1 1/2	Hrs. Town Shovel @6.50		9.75	1	3/4" C. Curb Cock 6.28
1	Hrs. Trucking @3.00		3.00	1	Box & Rod 4.90
			76.12	1 1/2	Straight tailpiece .50
				1 1/2	Offset tailpiece .50
				1/2	Hr. Town Shovel @6.25 3.25
					26.26

DATE \_\_\_\_\_

**TOWN OF LEXINGTON — BOARD OF PUBLIC WORKS**  
**WATER DIVISION**

Sketch of Service Here

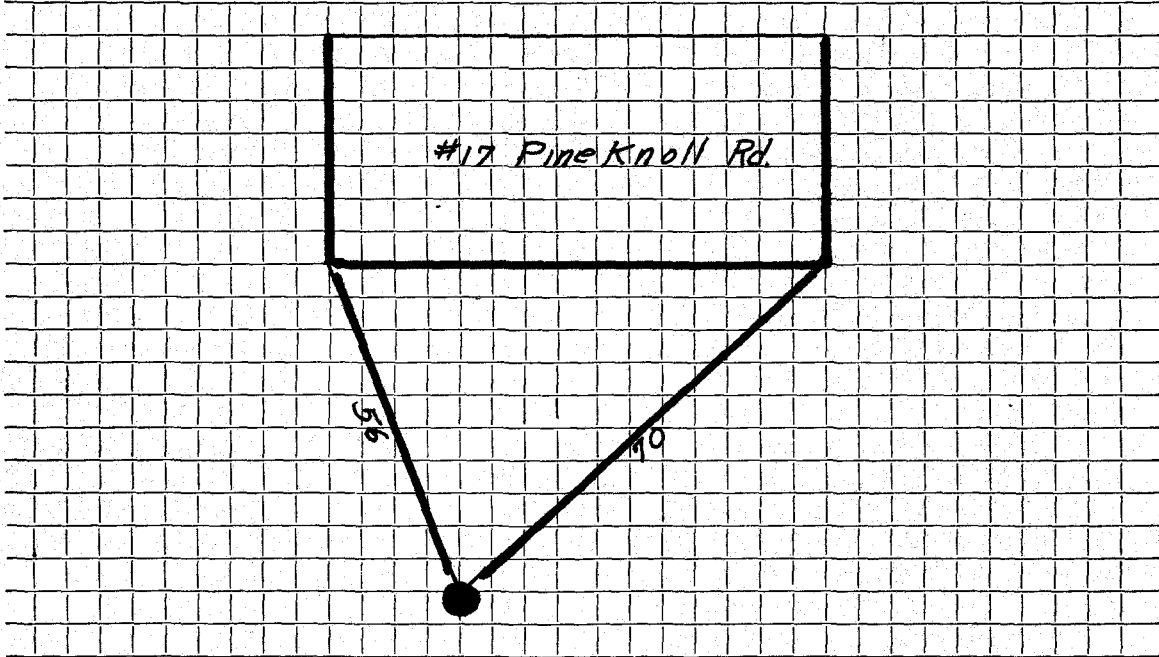

Connection made in ..... Street.      Work completed .....

Remarks: .....  
.....  
.....