

Name MARTIN Kiely w/ Kiely EXCAVATION

Service No.

Address 18 PINE KNOLL ROAD

Location

Kind of Pipe SDR-35

Size

6"

Size of Main

6"


Repair ~~Renewal~~ New Service

Location

Date	Material	Amount	Total	Date	Ar
1/26/21	(from ROAD to house)				
	6" → 6" FENCO	①			
	6" 22° BEND	①			
	6" SDR-35	~57'			
	6" YE - cleanout	①			
	4" - 6" FENCO	①			

WALKER DIVISION

Sketch of Service Here

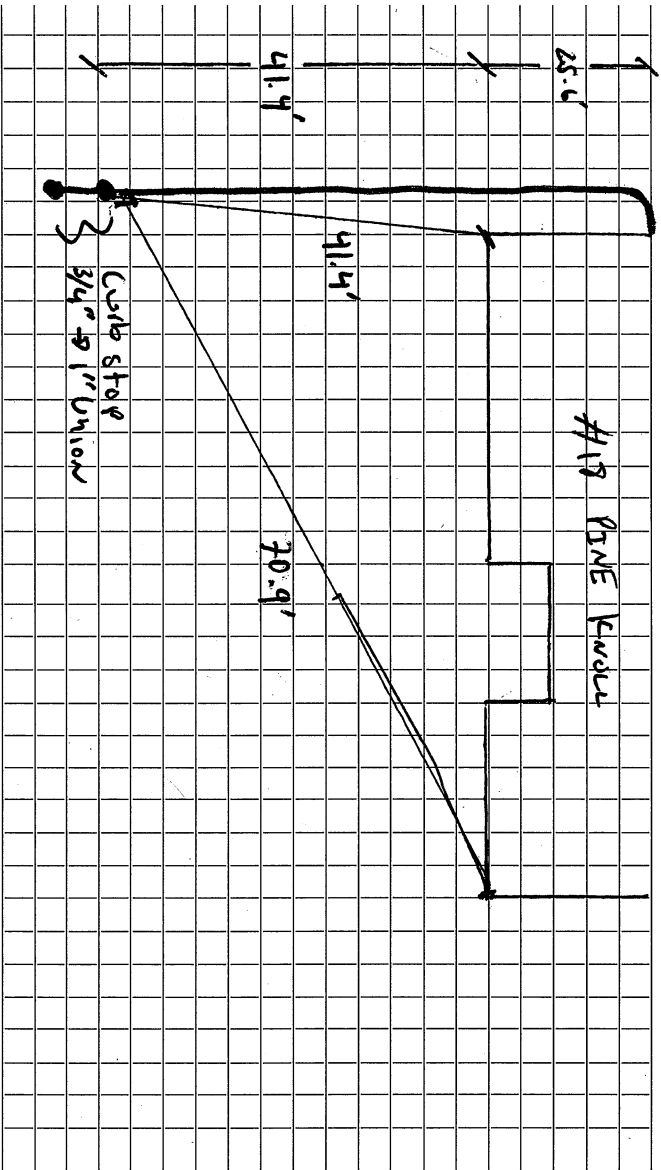

ion made in... PINE KWELL... Street. Work completed

\* Renewal

- ASL

Name Winston Johnston

Service No. 151

Address 18 Pine Knoll Road

Location 18 Pine Knoll Road

# 2345

Kind of Pipe

Size

Size of Main

~~Repair-Renewal~~ New Service Com. 9-19-49

Location

Date	Material	Amount	Total	Date	Material	Amount
Aug. 6, '49	Labor	2 45	2 45	Aug. 6, '49	Labor	50 00
	10% Overhead		25	Aug. 6, '49	Copper Tubing @.24	41 90
	34' - 3/4" Copper Tubing @.24		8 16	Aug. 6, '49	Labor	4 90
	1 - 3/4" C x 3/4" T.W.H. S&W		3 29	Aug. 6, '49	Copper Tubing @.24	5 28
	Littlefield Shovel 1 hr.		7 00	Aug. 6, '49	Curb-cock	3 15
	Trucking 1 hr.		75	Aug. 6, '49	Box & Rod	3 95
	Patching 20 x 3		20 00	Aug. 6, '49	Offset Tail Piece	37
			41 90	Aug. 6, '49	Stright Tail Piece	37
				Aug. 6, '49	Littlefield Shovel 2 hrs. @7.00	14 00
				Aug. 6, '49	Trucking 1 hr.	75
	Labor					36 62

*Deposited*  
Aug 26 1949  
Deposited  
S. J. Johnston

Non-Charge

TOWN OF LEXINGTON - BOARD OF PUBLIC WORKS

**WATER DIVISION**

The undersigned applies for a supply of water at No..... St. and hereby agrees to comply with the rules and regulations as now, or at any future time, established by the Board of Selectmen.

Am't of Estimate \$.....

Owner .....


Am't Paid \$.....

Address .....

Builder .....

.....

Sketch of Service Here

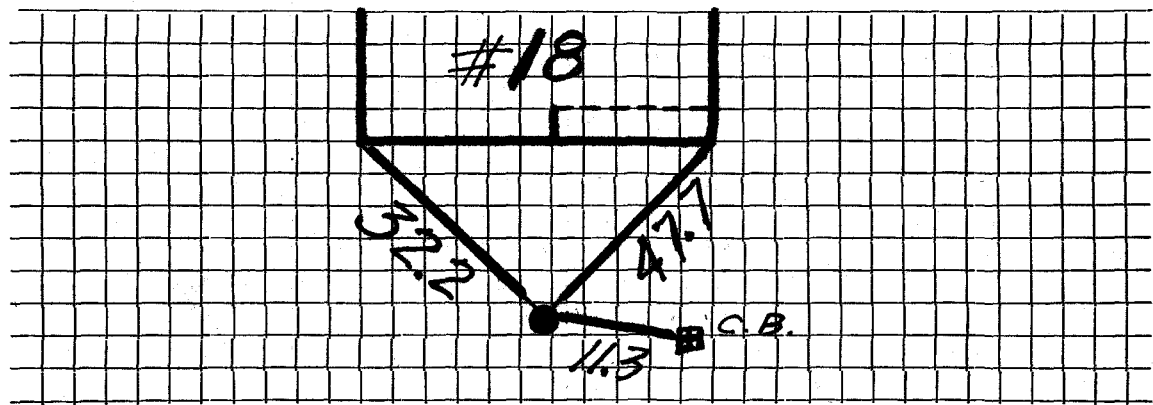

Connection made in ..... Street.

Work completed .....19

Remarks: