

Name Roy Wason

Service No. 28

Address 120 Westbourne Terrace, Brookline,
2 Pine Knoll Rd.

Location

#2
Lot E, Pine Knoll Road.

Kind of Pipe

Size

Size of Main

Deposit on Hydrant connection & new service.
~~Repair - Renewal - New Service~~

Location

Date	Material	Amount	Total	Date	Amount
1937					
Com. 4/4/37	Hydrant Con.				
	Chg. Stop & Waste		3 75	May 26, 1937 Deposited	25 00
	Construction Chg.		3 00	Sept 21, 1937 Refunded	3 00
	30 1/2' @ 50¢ (bal on #40)		15 25		22 00
			\$ 22 00		
	2 hrs. @ 60¢-	1 20			
	36' 3/4" C.T. @ 25¢	9 00			
	1 3/4" Adapter	5 75			
	1 3/4" S. & W.	3 75			
	2 hrs. trucking	1 50			
		21 20			
	Labor				

DATE May 26, 1927

TOWN OF LEXINGTON—BOARD OF PUBLIC WORKS

WATER DIVISION

The undersigned applies for a supply of water at No. Lot. E Pine Knoll Rd St. and hereby agrees to comply with the rules and regulations as now, or at any future time, established by the Board of Selectmen.

Am't. of Estimate \$ 25.00 Hyd. Conn.

Owner Ray Mason (per land)


Am't. Paid \$ _____

Address 1 Beakbourns Terrace

Builder _____

Brookline, Mass

Sketch of Service Here

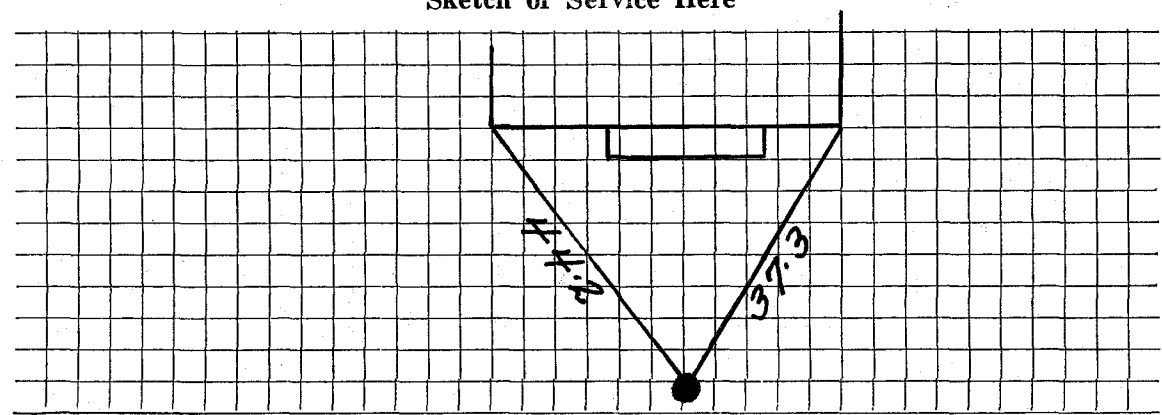

Connection made in _____ Street.

Work completed _____ 19

Remarks: