

WATER SERVICE RECORD

Name Roger Petrie

Service No. 60

Address 21 Pine Knoll Road

11 2837

Location Lexington, Mass.

~~Repair~~ ~~Renewal~~ New Service


Com. 8-6-51

Date	Material	Amount	Total	Date	Amount
4-16-51	Labor	2 87	2 87	4-12-51	50 00
	10% Overhead		29		7 00
	40' - 3/4" Copper Tubing @ .36	14 40	14 40		No Charge
	1 - 3/4" C x 1/2" I.W.H. S&W	1 00	1 00	4-16-51	Labor
	Littlefield Shovel 2 hrs. @ 7.00	14 00	14 00		2 87
	Trucking 1 hr. @ .75	75	75		15' - 3/4" Copper Tubing @ .36
	Patching 6 x 3	6 00	6 00		1 - 3/4" C Corp-cock
			42 31		1 - 3/4" C x 3/4" C Curb-cock
					1 - Box & Rod
					1 - 1/2" Offset Tail Piece
					1 - 1/2" Straight Tail Piece
					Littlefield Shovel 1 hr. @ 7.00
					Trucking 1 hr. @ .75
					75
					30 70

DATE \_\_\_\_\_

TOWN OF LEXINGTON — BOARD OF PUBLIC WORKS  
WATER DIVISION

Sketch of Service Here

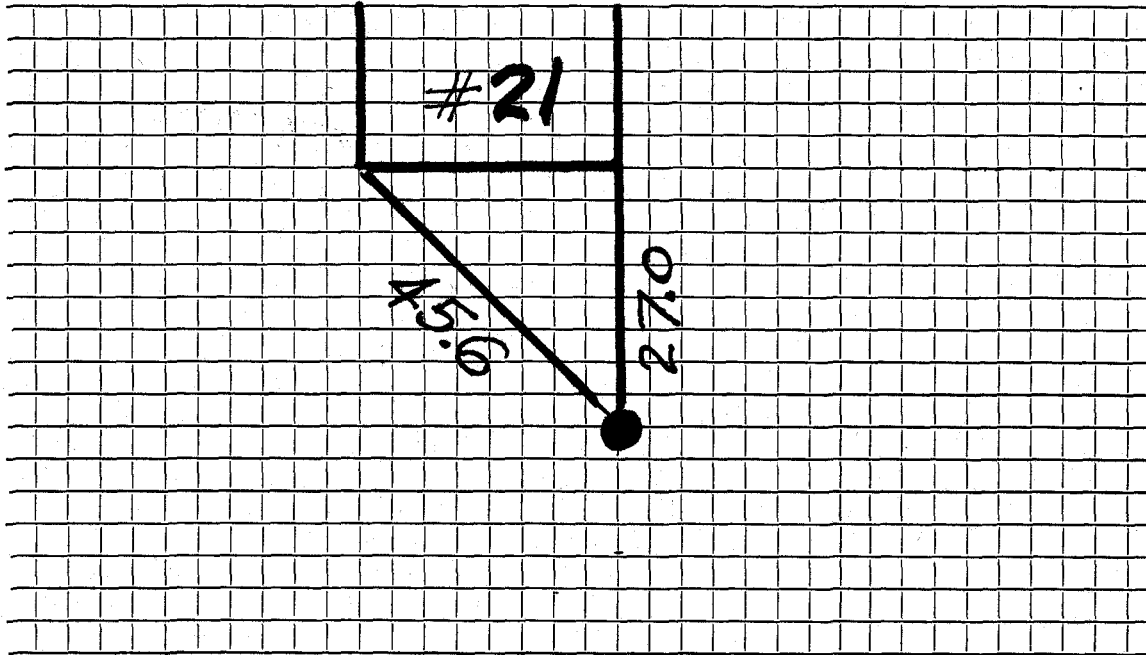

Connection made in ..... Street. Work completed .....

Remarks: .....

.....  
.....