

Name Donald R. Stevenson

Service No. 11

Address 22 Pine Knoll Road

#1944

Lexington, Mass.

Location 22 Pine Knoll Road

Kind of Pipe

Size

Size of Main

~~REPAIR WORK~~ New Service

Com. 2-21-49

Location

Date	Material	Amount	Total	Date	Amount
Jan. 17, '49	Labor	3 15	3 15	Jan. 13, '49	50 00
	10% Overhead		32	Jan. 18, '49	6 19
	40' - 3/4" Copper Tubing @.27	13 50			56 19
	1 - 3/4" C x 1/2" I.W.H. S&W	3 15			Non-Charge
	1 - 3/4" C x 3/4" C Union (3 pt)	1 32		Jan. 17, '49	Labor
	Littlefield Shovel 2 hrs. @7.00	14 00			2 30
	Trucking 1 hr.		75		23' - 3/4" Copper Tubing @.27
	Patching 20 x 3		20 00		1 - 3/4" C Corp-cock
			56 19		1 - 3/4" C x 3/4" C Gurb-cock
					1 - Box & Rod
					1 - 1/2" Offset Tail Piece
					1 - 1/2" Straight Tail Piece
					Littlefield Shovel 1 hr. @7.00
					Trucking 1 hr.
					75
	Labor				27 09

Bill sent 2-23-49

DATE \_\_\_\_\_

TOWN OF LEXINGTON – BOARD OF PUBLIC WORKS

**WATER DIVISION**

The undersigned applies for a supply of water at No..... St. and hereby agrees to comply with the rules and regulations as now, or at any future time, established by the Board of Selectmen.

Am't of Estimate \$.....

Owner .....


Am't Paid \$.....

Address .....

Builder .....

.....

Sketch of Service Here

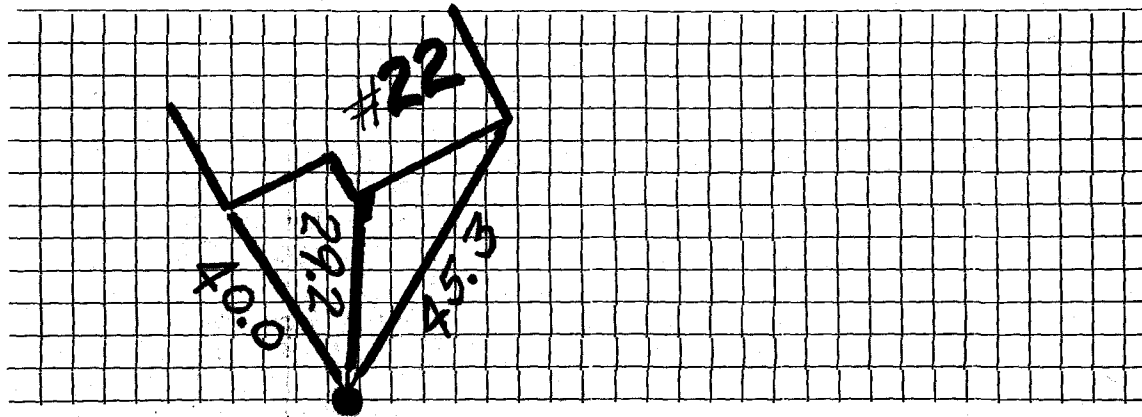

Connection made in ..... Street.

Work completed .....19

Remarks: