

Name Roger N. Wigglesworth

Service No.

67

Address 2 1/2 Pine Knoll Road

383

Lexington, Mass

Location 2 1/2 Pine Knoll Road

Kind of Pipe

Size

Size of Main

~~XXXXXXXXXX~~ New Service

Com. 6-11-49

Location

Date	Material	Amount	Total	Date	Amount
May 11, '49	Labor	1 20		May 9, '49	60 00
12	"	2 35	3 55	June 28, '49	8 41
	10% Overhead		36		51 56
	43' - 3/4" Copper Tubing @.27		11 61	May 12, '49	4 75
	1 - 3/4" C x 1/2" I.W.H. s&w		3 29	23' - 3/4" Copper Tubing @.27	6 21
	Littlefield Shovel 2 hrs. @7.00		14 00	1 - 3/4" C Corp-cock	3 15
	Trucking 1 hr. @.75		75	1 - 3/4" C x 3/4" C Curb-cock	3 85
	Patching 18 x 3		18 00	1 - 3/4" C x 3/4" C Union(3pts)	1 39
			51 56	1 - Box & Rod	3 95
				1 - 1/2" Offset Tail Piece	37
				1 - 1/2" Straight Tail Piece	37
				Littlefield Shovel 2 hrs. @7.00	14 00
	Labor			Trucking 1 hr. @.75	75
					38 79

DATE _____

TOWN OF LEXINGTON - BOARD OF PUBLIC WORKS

WATER DIVISION

The undersigned applies for a supply of water at No..... St. and hereby agrees to comply with the rules and regulations as now, or at any future time, established by the Board of Selectmen.

Am't of Estimate \$.....

Owner


Am't Paid \$.....

Address

Builder

.....

Sketch of Service Here

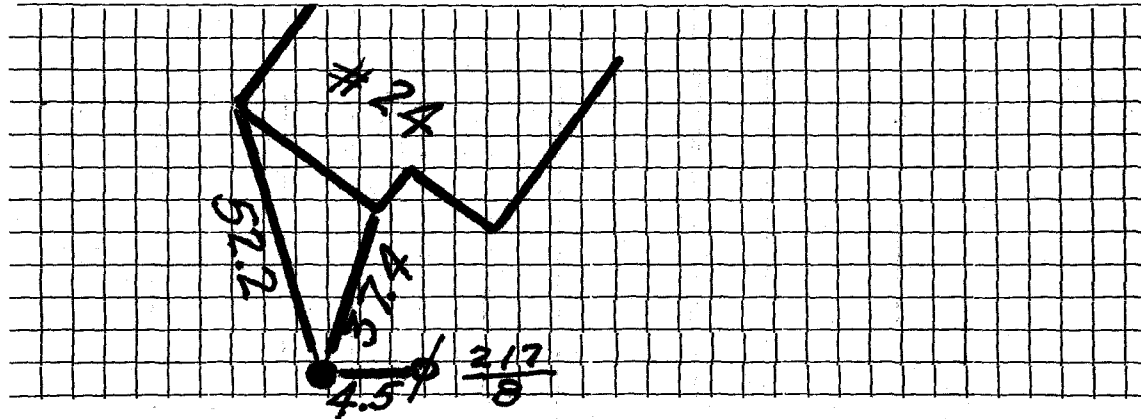

Connection made in Street.

Work completed19

Remarks: