

Name John E. Rowan

Service No. 2223

Address 115 Franklin St., Arlington
26 Pineknoll Rd.

Location Lot I & 1/2 of H, Pineknoll Rd. #26

Kind of Pipe Size Size of Main

Repair - Renewal - New Service

Location

Date	Material	Amount	Total	Date	Amount
9-19-33 Comm. 23.40	46 1" C.L. Pipe @.27	\$12 42		Sept. 1 1933 - Cash	23 40
	2 1" L.L. Coup. @.16	32			
	2 1" Br. Sp. Nip. @.15	30			
	2 1" L.L. Ells @.22	44			
	1 S & W	2 75			
	Trucking	75	16 98		
8/6/33	6 Hrs. Labor @.55	3 30			
	3 " " @.60	1 80	5 10		
	15% Overhead		77		
	COST		22 85		
CHARGE	46 ft. @ .45	\$20 70	\$20 70		
	Labor				
	Inasmuch as cost exceeds cost per foot figure, let it stand at estimated price of		\$23 40		

Hadley Press, Inc., Lexington

DATE Sept. 1, 1933

TOWN OF LEXINGTON—BOARD OF PUBLIC WORKS

WATER DIVISION

$$\begin{array}{r} 115 \\ 7 \\ \hline 52 \\ 45 \\ \hline 260 \\ 208 \\ \hline 2340 \end{array}$$

The undersigned applies for a supply of water at No. 1 + 1/2 H Pine Knoll St. and hereby agrees to comply with the rules and regulations as now, or at any future time, established by the Board of Selectmen.

Am't. of Estimate \$ 23 ⁴⁰

Owner John E. Rowan


Am't. Paid \$ 23 ⁴⁰

Address 115 Franklin St.

Builder George A. Wallen
282 Shelburn Road, Belmont

Arlington, Mass.

Sketch of Service Here

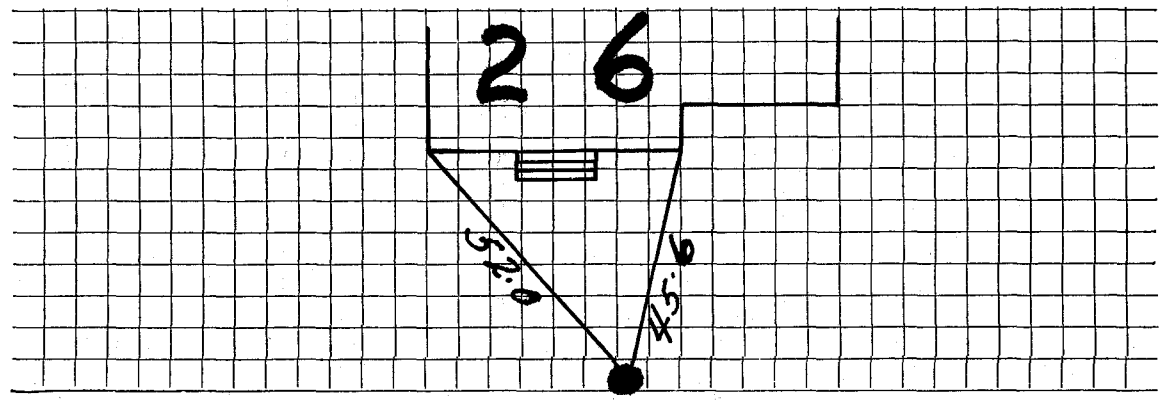

Connection made in _____ Street.

Work completed _____ 19

Remarks: