

Name V. H. Wigglesworth

Service No. 142

Address 3 Pine Knoll Road

Lexington, Mass.

Location 3 Pine Knoll Road

Kind of Pipe

Size

Size of Main

~~Repair - Renewal~~ - New Service

Com. 5/22/50

Location

Date	Material	Amount	Total	Date	Amount
Apr. 5, '50	Labor	2 55	2 55	April '50	60 00
	10% Overhead		26	May 28 '50	30 40
	32' - 3/4" Copper Tubing @.23		7 36		29 60
	1 - 3/4" C x 1/2" I.W.H. S&W		3 29	Apr. 5, '50	Labor 2 55
	1 - 3/4" C x 3/4" C Union (3pts)		1 39	12' - 3/4" Copper Tubing @.23	2 76
	Littlefield Shovel 2 hrs. @7.00	14 00	14 00	1 - 3/4" C Corp-cock	3 15
	Trucking 1 hr. @.75		75	1 - 3/4" C x 3/4" C Gurb-cock	3 85
			29 60	1 - Box & Rod	3 70
				1 - 1/2" Offset Tail Piece	38
				1 - 1/2" Straight Tail Piece	38
				Littlefield Shovel 1 hr. @7.00	7 00
				Trucking 1 hr. @.75	75
	Labor				24 52

TOWN OF LEXINGTON – BOARD OF PUBLIC WORKS

WATER DIVISION

The undersigned applies for a supply of water at No..... St. and hereby agrees to comply with the rules and regulations as now, or at any future time, established by the Board of Selectmen.

Am't of Estimate \$.....

Owner


Am't Paid \$.....

Address

Builder

.....

Sketch of Service Here

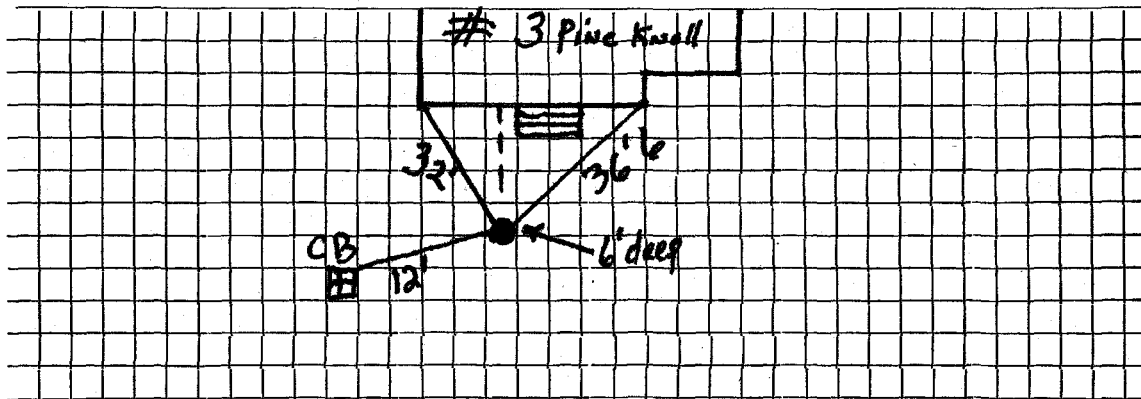

Connection made in Street.

Work completed19

Remarks: