

Name Albertine P. Hardy

Service No. ~~2224~~ 2224

Address 147 School St., Watertown
30 Pineknoll Rd.

Location Lot J, Pineknoll Road #30

Kind of Pipe

Size

Size of Main

~~Repair-Renewal~~ - New Service

Location

Date	Material	Amount	Total	Date	Amount
11/16/34-45' <i>N-27-34 Com. 20.25 to Russell</i>	1" C.L. Pipe @.20	\$9 00		Nov. 6 1934 - Deposit	20 25 [✓]
	2 1" L.L. Coup. @.25	50			
	1 1" L.L. Ell.	30			
	1 1" Br. Sp. Nipple	18			
	1 S & W	2 75			
	Trucking	75	\$13 48		
	2 Hrs. Labor @.55	1 10			
	2 " " @.60	1 20	2 30		
	10% Overhead		23		
	COST		16 01		
	Labor				
CHARGE	45' @ .45	\$20 25	\$20 25		

Hadley Press, Inc., Lexington

DATE October 16th, 1934

TOWN OF LEXINGTON—BOARD OF PUBLIC WORKS

WATER DIVISION

$$\begin{array}{r} 45 \\ 45 \\ \hline 225 \\ 180 \\ \hline 2025 \end{array}$$

The undersigned applies for a supply of water at No. Lot 7 Pine Knoll Road St. and hereby agrees to comply with the rules and regulations as now, or at any future time, established by the Board of Selectmen.

Am't. of Estimate \$ 20 ²⁵

Owner

Albertine P. Farley


Am't. Paid \$ 20 ²⁵

Address

147 School St
Watertown, Mass.

Builder Hans Johnson
191 Newport St. Arlington

Sketch of Service Here

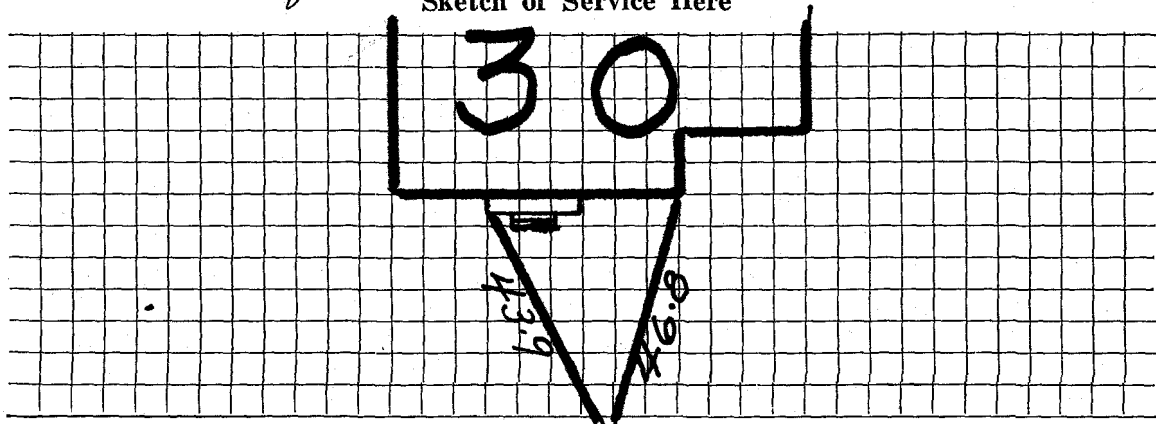

Connection made in _____ Street.

Work completed _____ 19

Remarks: