

Name V. H. Wigglesworth

Service No. 112

Address 5 Pine Knoll Road

6639

Lexington, Mass.

Location 5 Pine Knoll Road

Kind of Pipe

Size

Size of Main

~~REPAIR WORK~~—New Service

Com. 5/22/50

Location

Date	Material	Amount	Total	Date	Amount
Apr. 4, '50	Labor	5 10	5 10	April 1 '50	Deposited 60 00
	10% Overhead		51	May 25 '50	Refunded 27 61
	38' - 3/4" Copper Tubing @.23	8 74	8 74		No Charge 32 39
	1 - 3/4" C x 1/2" I.W.H. S&W	3 29	3 29	Apr. 5, '50	Labor 2 55
	Littlefield Shovel 2 hrs. @7.00	14 00	14 00		9' - 3/4" Copper Tubing @.23 2 07
	Trucking 1 hr. @.75		75		1 - 3/4" C Corp-cock 3 15
			32 39		1 - 3/4" C x 3/4" Curb-cock 3 85
					1 - Box & Rod 3 70
					1 - 1/2" Offset Tail Piece 38
					1 - 1/2" Straight Tail Piece 38
					Littlefield Shovel 1 hr. @ 7.00 7 00
					Trucking 1 hr. @.75 75
	Labor				23 83

TOWN OF LEXINGTON – BOARD OF PUBLIC WORKS

WATER DIVISION

The undersigned applies for a supply of water at No..... St. and hereby agrees to comply with the rules and regulations as now, or at any future time, established by the Board of Selectmen.

Am't of Estimate \$.....

Owner


Am't Paid \$.....

Address

Builder

.....

Sketch of Service Here

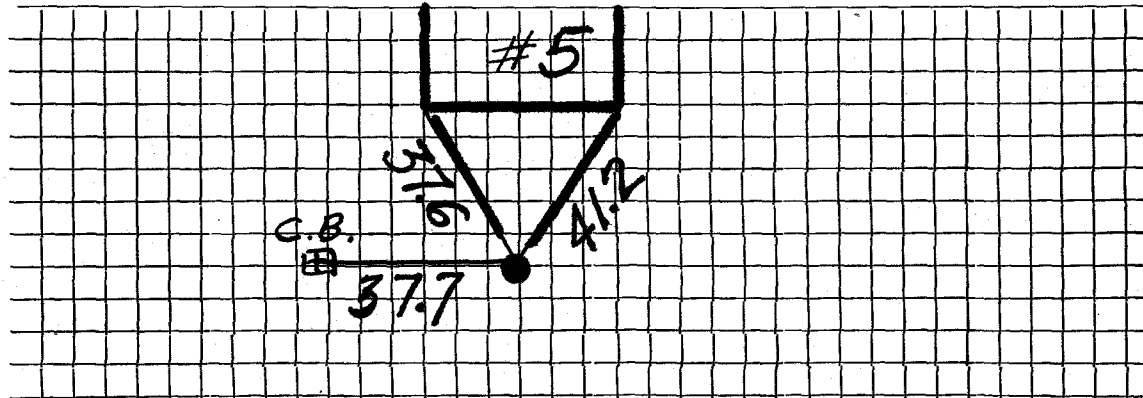

Connection made in Street.

Work completed19

Remarks: