

Check from:

Name Edwin H. Nelson, Builder

Owner, Reliance Co-op. Bank

Service No. ~~25~~ 2221

Address 34 Marlboro Road, Waltham, Mass.

6193

9 Pine Knoll Road

Location 9 Pine Knoll Road (Lot #2)

Kind of Pipe

Size

Size of Main

Repair—Renewal—New Service

Location

Date

Material

Amount

Total

Date

Amount

5/16/40

4 hrs. @ 60¢

2 40

May 8, 1940 Deposited.

2000

Com 7/20/40

10% Overhead

24

2 64

May 14, 1940 Repaid

7 66

35' 3/4" Copper tubing @ 17¢

17¢

5 95

1 3/4" C.x1/2" I. S.& W.

2 25

Trucking, 2 hrs. @ 75¢

1 50

12 34

12 34

Labor

original
with
signature
of
selectmen

DATE May 2, 1940.

TOWN OF LEXINGTON—BOARD OF PUBLIC WORKS

WATER DIVISION

#6 #9 per engineers
8-26-68

The undersigned applies for a supply of water at No. Lot # 2 Pine Knoll Rd St. and hereby agrees to comply with the rules and regulations as now, or at any future time, established by the Board of Selectmen.


Am't. of Estimate \$ 20⁰⁰

Am't. Paid \$ _____

Builder _____

Owner Reliance Coop Bldg.
Address 34 Marlboro Rd
Waltham

Sketch of Service Here

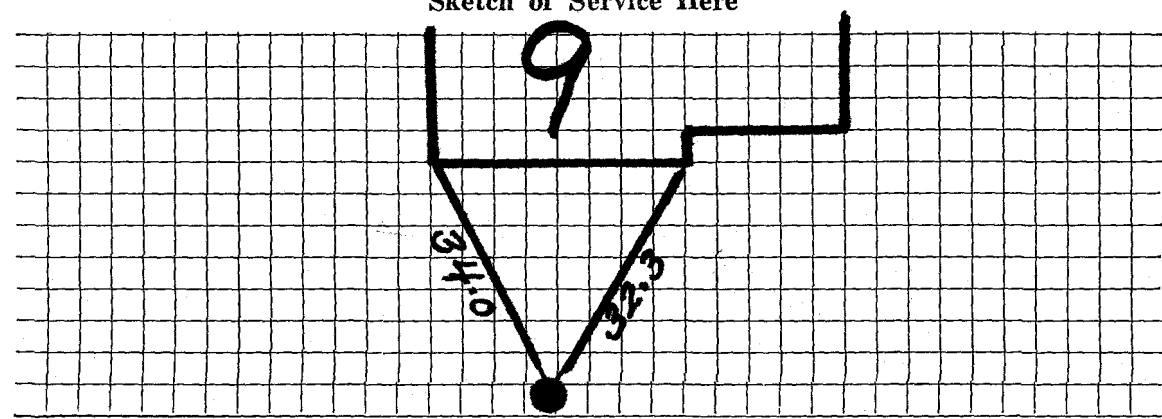

Connection made in _____ Street.

Work completed _____ 19

Remarks: