

Name Janet T. Smith

Service No. 2226

Address 18 Pinewood St.

Locatio Same

Kind of Pipe

Size

Size of Main

Repair—Renewal—New Service

Location

Date	Material	Amount	Total	Date	Amount
April 18	5 hrs. @ 55¢	2 75			
<i>Com. to Russell</i>	3 " @ 60¢	<u>1 80</u>	4 55	<i>April 8, 1935 - Deposited</i>	16 00
<i>6-18-35 & 18-26</i>	10% Overhead-labor		46	<i>June 26, 1935</i>	<u>2 26</u>
	40' 1" C.L. Pipe @20¢		8 00		18 26
	3 1" L.L. Coup. 25¢		75		
	2 1" L.L. Ells 30¢		60		
	2 1 " Brass Nipples 20¢		40		
	1 S. & W.		2 75		
	Trucking		<u>75</u>		
			<u>18 26</u>		
	Labor				

DATE April 8, 1935

TOWN OF LEXINGTON—BOARD OF PUBLIC WORKS

WATER DIVISION

The undersigned applies for a supply of water at No. 18 Pinewood ^{Street} St. and hereby agrees to comply with the rules and regulations as now, or at any future time, established by the Board of Selectmen.

Am't. of Estimate \$ 16.00

Owner


Janet J. Smith
by H. H. Johnson

Am't. Paid \$ _____

Address

Builder _____

Sketch of Service Here

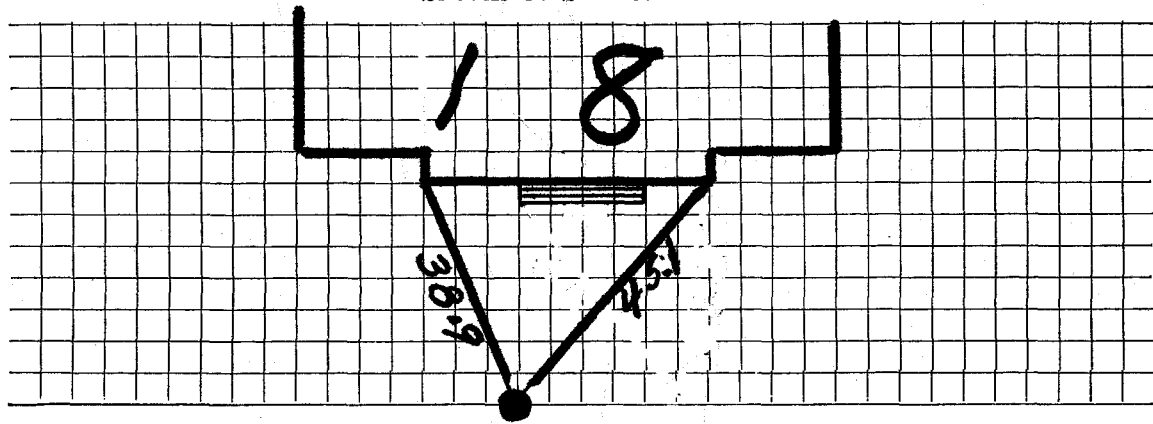

Connection made in _____ Street.

Work completed _____ 19

Remarks: