

WATER SERVICE RECORD

Name Fred Hayes

Service No. 13

Address 2 Pinewood Street

Location

~~Repair or Renewal~~ — New Service W.O.#2155 *Valeri #2493*

FEB 10 1975


Date	Material	Amount	Total	Date		Amount
6-10-1974	Labor	6.77		<i>6-5-74</i>	<i>Deposit</i>	<i>125 00</i>
	10% O.H.	.68	\$7.45	<i>5-11-75</i>	<i>Refund</i>	<i>113 54</i>
20'	3/4" K Type Copper	@1.05	21.00			<i>61 43</i>
1	3/4" Corporation		10.53			
1	3/4" Curb Cock		12.45			
1	Box & Rod		10.00			
			\$61.43			

DATE _____

TOWN OF LEXINGTON — BOARD OF PUBLIC WORKS

WATER DIVISION

Sketch of Service Here

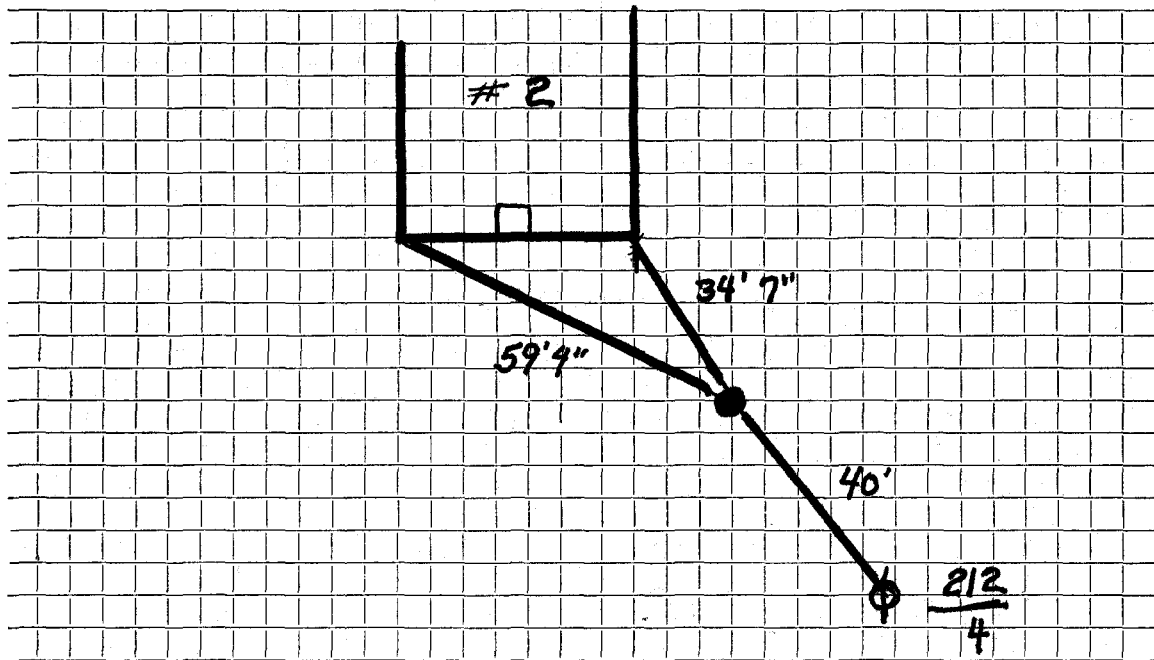

Connection made in Street. Work completed

Remarks:

.....

.....