

WATER SERVICE RECORD

Name Irving Fowler

Service No. 156

Address 3 Pinewood Street

7242

Location

REPAIR-RENTAL—New Service

Com. 8-30-54


Date	Material	Amount	Total	Date	Amount
7/24/54	Labor	1 85		7-6-54 Deposited	25 00
	10% overhead	19	2 04	8-30-54 Refunded	(1 06
	49' - 3/4" copper tubing@.35		17 15		<u>23 94</u>
	1 - 3/4"C. x 1/2 I.W.H. stop& waste		4 00		NON CHARGE
	1 hr. trucking		75	7/24/54 Labor	1 85
			23 94	16' - 3/4" copper tubing@.35	5 60
				1 - 3/4"C. corp-cock	4 33
				1 - 3/4"C. curb-cock	4 67
				1 box and rod	3 90
				1 - 1/2 straight tail pc.	50
				1 - 1/2 offset tail pc.	50
				1 hr. trucking	75
					<u>22 10</u>

DATE _____

TOWN OF LEXINGTON — BOARD OF PUBLIC WORKS

WATER DIVISION

Sketch of Service Here

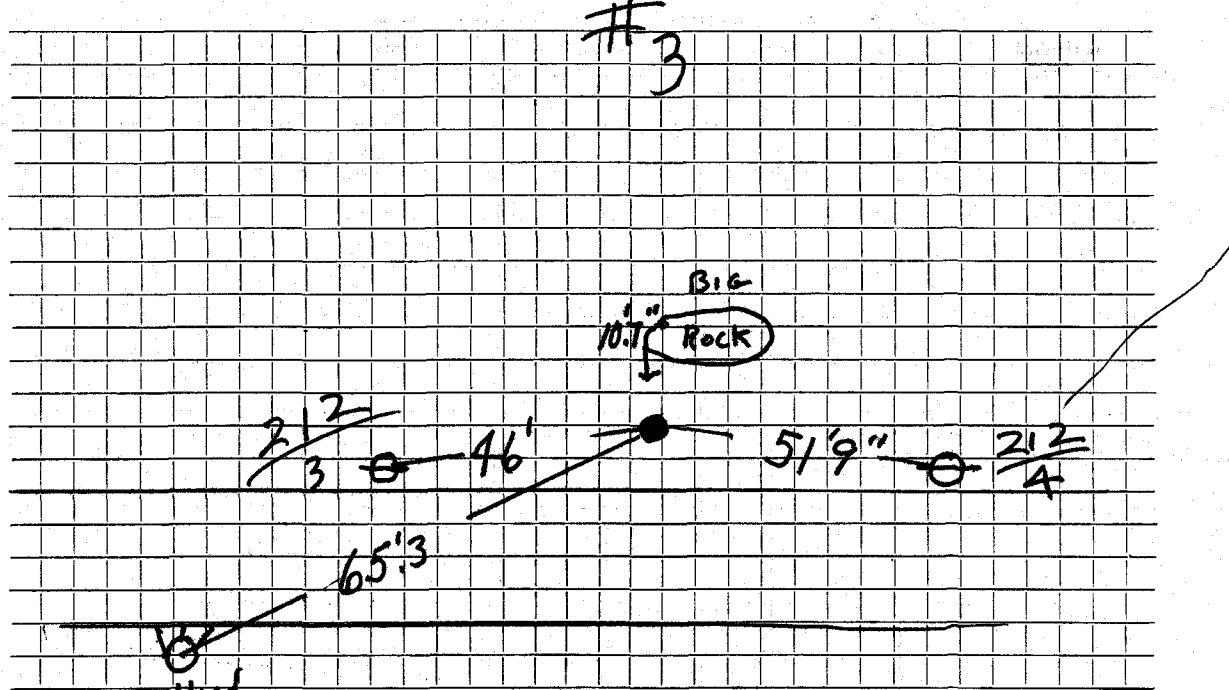

Connection made in Street. Work completed

Remarks:

.....

.....