


DATE SEPT 2001

TOWN OF LEXINGTON — BOARD OF PUBLIC WORKS
WATER DIVISION

Sketch of Service Here

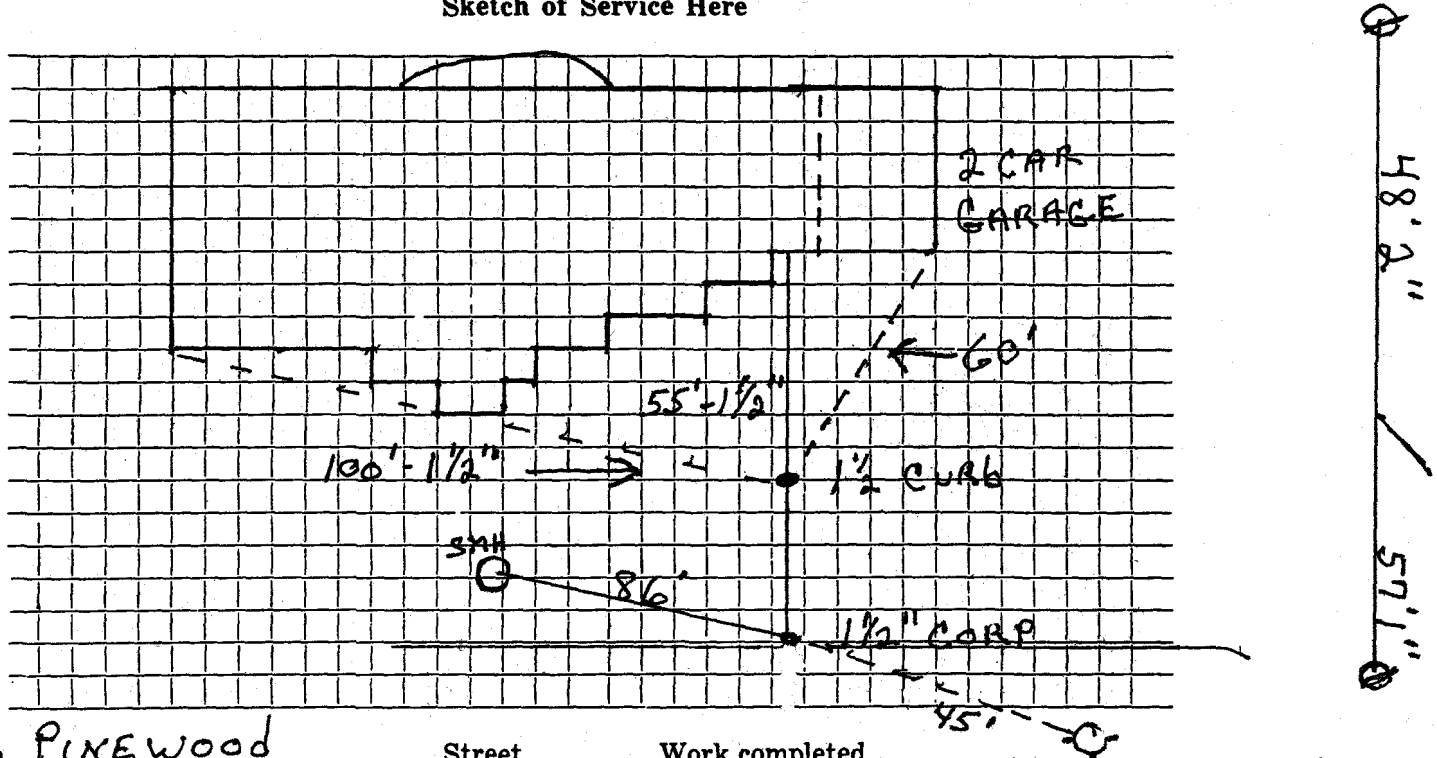

Connection made in PINEWOOD Street. Work completed

Remarks: INSTALLED BY J.M. McLAUGHLIN