

WATER SERVICE RECORD

Name Joseph Borozne

Service No. 53

Address 1 Piper Road

Location

~~Repair - Renewal~~ New Service W.O. 4524 Devine #2931

MAR 15 1976


Date	Material	Amount	Total	Date	Amount
12/9/75	Labor	62.19		11-25-75	800.00
	10% O.H.	6.22	68.41	5-15-76	58.55
12'	1" Copper tubing @1.30		15.60		511.45
1	1" Corporation		16.69		
1	Curb Box		15.40		
$\frac{1}{2}$	ton Cold Patch		6.85		
2	hrs. Trucking @3.00		6.00		
1	hr. Compressor		5.00		
3	hrs. Town Shovel @6.50		19.50		
	Street Patch 9' x 10'		30.00		
	Sidewalk Patch 5' x 16'		27.00		
			210.45		
12/15/75	93' 1" Copper tubing				

DATE _____

TOWN OF LEXINGTON — BOARD OF PUBLIC WORKS

WATER DIVISION

Sketch of Service Here

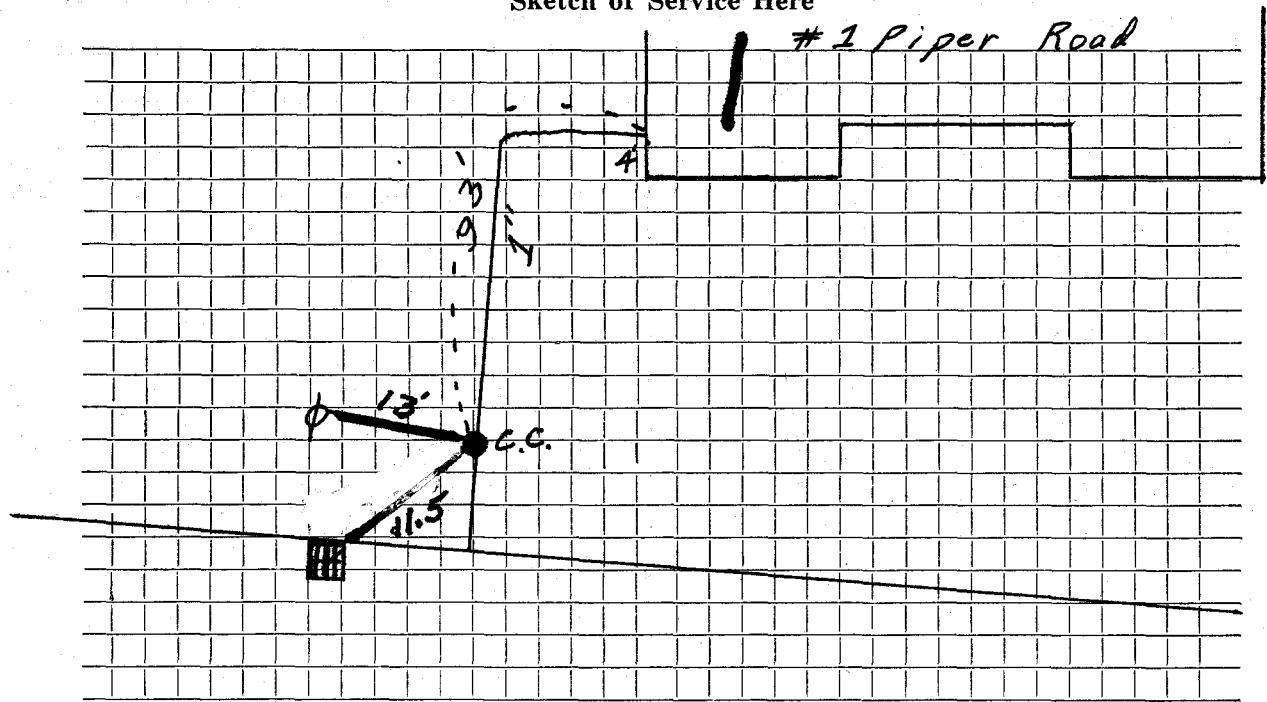

Connection made in Street. Work completed

Remarks:
.....
.....