

## WATER SERVICE RECORD

2575

Name Dorothy R. Foster

Service No. 29

Address 10 Plainfield St.

Location

~~Repair—Renewal—New Service~~ W. O. # 8120

JAN 17 1972


Date		Material	Amount	Total	Date	Amount
9/17/71		Labor		71 92	9-16-71	Deposit 200 00
		10% O.H.		7 19	1-17-72	Refund 60 48
	29'	3/4" Copper pipe	.79	22 91		139 52
	1	3/4" Wheel Valve		9 30	7-31-47	
	2	Yds. Loam @ 3.50		7 00	26'	3/4" Copper
	2	Hrs. Trucking 3.00		6 00	1	3/4" C. Adapter
	2	Lbs. Grass seed 1.10		2 20	1	1" l. X 3/4" l. Curb Cock
	2	Hrs. Shovel 6.50		<u>13 00</u>	1	1" l. X 3/4" C. - 2 Part Union
				139.52		

DATE \_\_\_\_\_

TOWN OF LEXINGTON — BOARD OF PUBLIC WORKS

**WATER DIVISION**

Sketch of Service Here

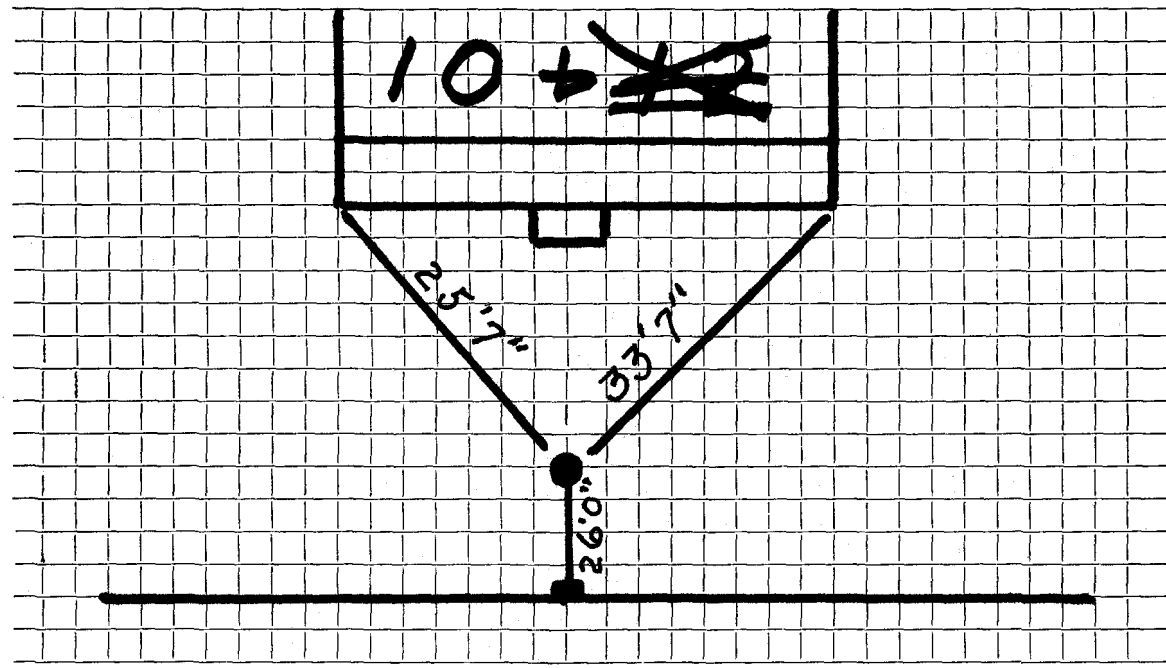

Connection made in ..... Street.      Work completed .....

Remarks: .....  
.....  
.....