

Name Gladys Colwell

Service No. # 2233

Address 15 Bartlett Avenue, Lexington
11 Plainfield St.

#11

#5000

Location Lot 6A Plainfield St.,

Kind of Pipe

Size

Size of Main

~~Repair - Renewal~~ - New Service

Location

Date
1939

Material

Amount

Total

Date

Amount

April 12,

2 hours @ 60¢

1 20

April 8, 1939

Deposited

18 00

34' 3/4" Copper Tubing @ 20¢

6 80

1 3/4" S. & W.

3 75

2 3/4" C.Unions (3 part)

2 20

Trucking, 2 hrs. @ 75¢

1 50

\$ 15 45

Flat Rate:

36' @ 50¢

\$18 00

Labor

town dig: Sewer 100.00
 Water 18.00
 118.00

owner dig: Sewer 65.00
 Water 18.00
 83.00

DATE February 24 1939

TOWN OF LEXINGTON - BOARD OF PUBLIC WORKS

WATER DIVISION Lot. 6 A.
 cost: 80.00 Sewer: Town dig
 50.00 " ; owner "

The undersigned applies for a supply of water at No. Plainfield - St. and hereby agrees to comply with the rules and regulations as now, or at any future time, established by the Board of Selectmen.

Am't. of Estimate \$ _____

Owner Gladys M. Colwell

Am't. Paid \$ _____


Address 15 Bartlett Ave.

Builder _____

M+S.
 Lexington Mass.

Water no change in price.

Sketch of Service Here

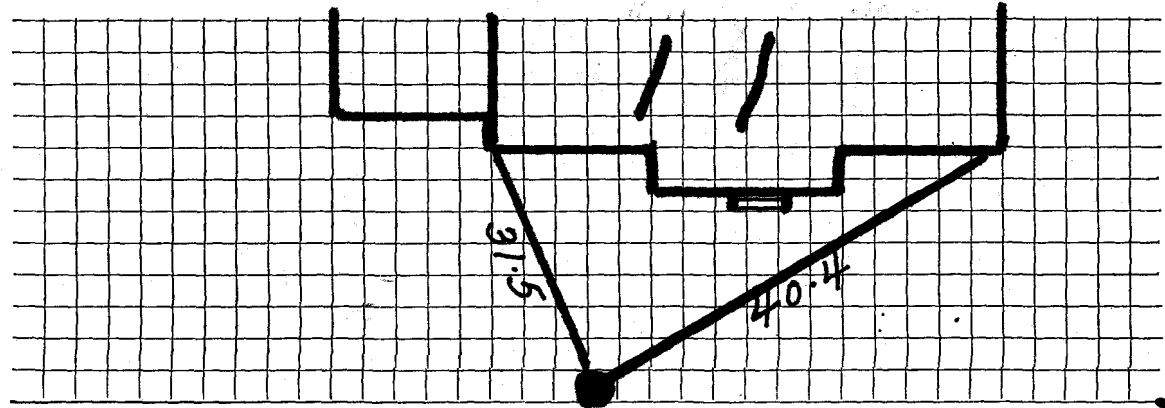

Connection made in _____ Street.

Work completed _____ 19

Remarks: