




TOWN OF LEXINGTON — BOARD OF PUBLIC WORKS

WATER DIVISION

Sketch of Service Here

A

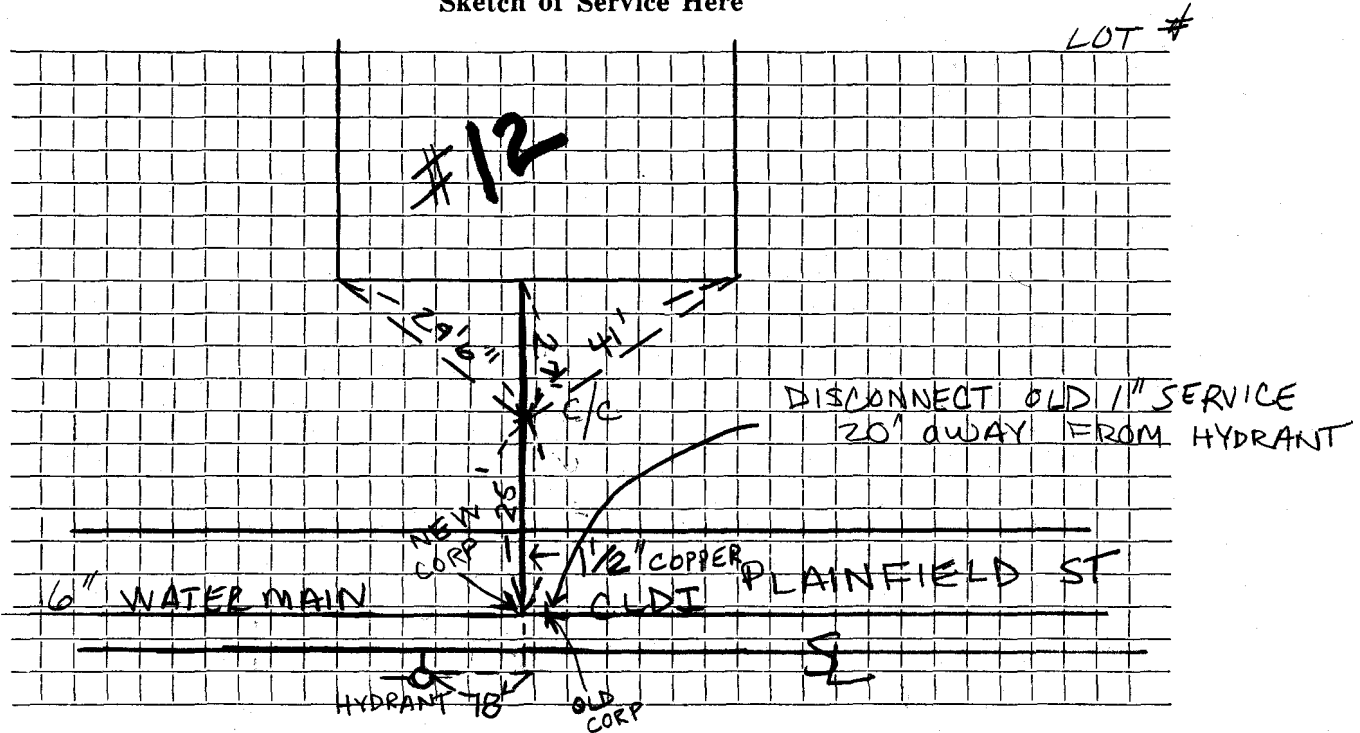

Connection made in ..... Street. Work completed .....

Remarks: .....  
.....  
.....