

Name

Service No. 2229

Address

7 Plainfield St.

1532

Location

7 Plainfield St.

Kind of Pipe

Size

Size of Main

Repair—Renewal—New Service

W.O. # 5968

Location

Date

Material

Amount

Total

Date

Amount

12/5/67

Labor \$44.79

10% O.H. \$4.48

\$49.27

1 hr. Trucking

\$3.00

1 hr. Shovel

\$6.50

9' 3/4" Copper pipe

\$7.11

1 3/4" Adaptor

\$2.76

1 3/4" Curb Lock

\$11.32

1 1" Coupling

86

1 1"x3/4" Bushing

\$1.42

1 3/4"x6" Nipple

31

1 1" Repair Clamp

\$5.05

1 Labor Curb Box

\$5.45

1/4 Ton cold patch

\$1.38

\$94.43

DATE _____

TOWN OF LEXINGTON—BOARD OF PUBLIC WORKS

WATER DIVISION

The undersigned applies for a supply of water at No. _____ St. and hereby agrees to comply with the rules and regulations as now, or at any future time, established by the Board of Selectmen.

Am't. of Estimate \$ _____


Owner Carl G. Swanson

Am't. Paid \$ _____

Address 7 Plainfield St.

Builder _____

Sketch of Service Here

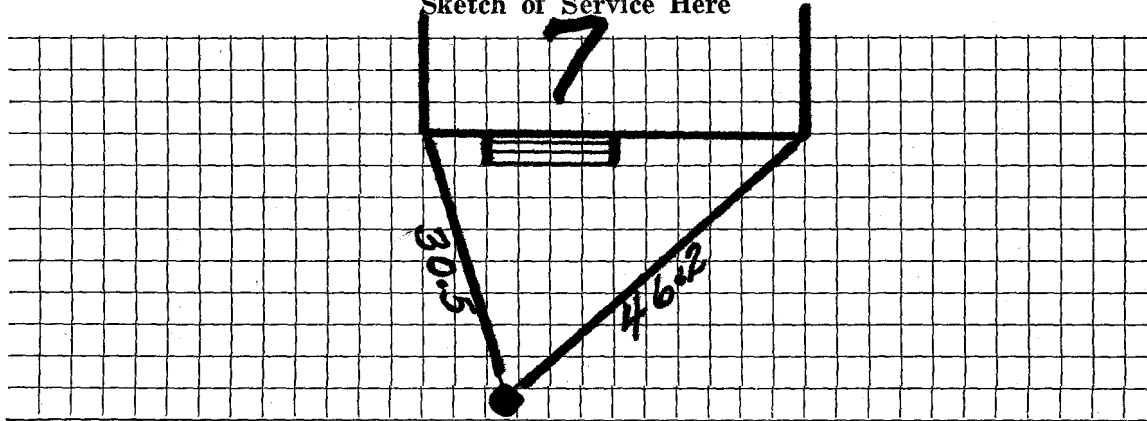

Connection made in _____ Street.

Work completed _____ 19

Remarks: