

WATER SERVICE RECORD

Name Edward L. Mahoney

Service No. 81

Address 8 Plainfield Street

Location

~~Repair~~ - Renewal - ~~Water Service~~

Conn 8-1-60


Date	Material	Amount	Total	Date	Amount
6-6-60	Labor	40 04		5-25-60	Deposit 75 00
	10% O.H.	4 00	44 04	2-9-61	Paid 1 97
28'	3/4" Copper tubing @42		11 76		76 97
1	3/4" Cx 1/2 I.W.H. Stop&Waste		6 17		
2	Hrs. pippin shovel @4.50		9 00		NON CHARGE
2	Hrs. Trucking @3.00		6 00		Labor 42 03
			76.97	23'	3/4" Copper tubing @42- 9 66
				1	3/4" C Corp Cock 4 91
				1	3/4" C Curb Cock 6 28
				1	Box & Rod 5 00
				1	1/2 Straight tailpiece 50
				1	1/2 Offset tailpiece 50
					20 x 3 Patch 20 00
					88 88
				Bill sent 8-1-60	1.97

DATE _____

TOWN OF LEXINGTON — BOARD OF PUBLIC WORKS

WATER DIVISION

Sketch of Service Here

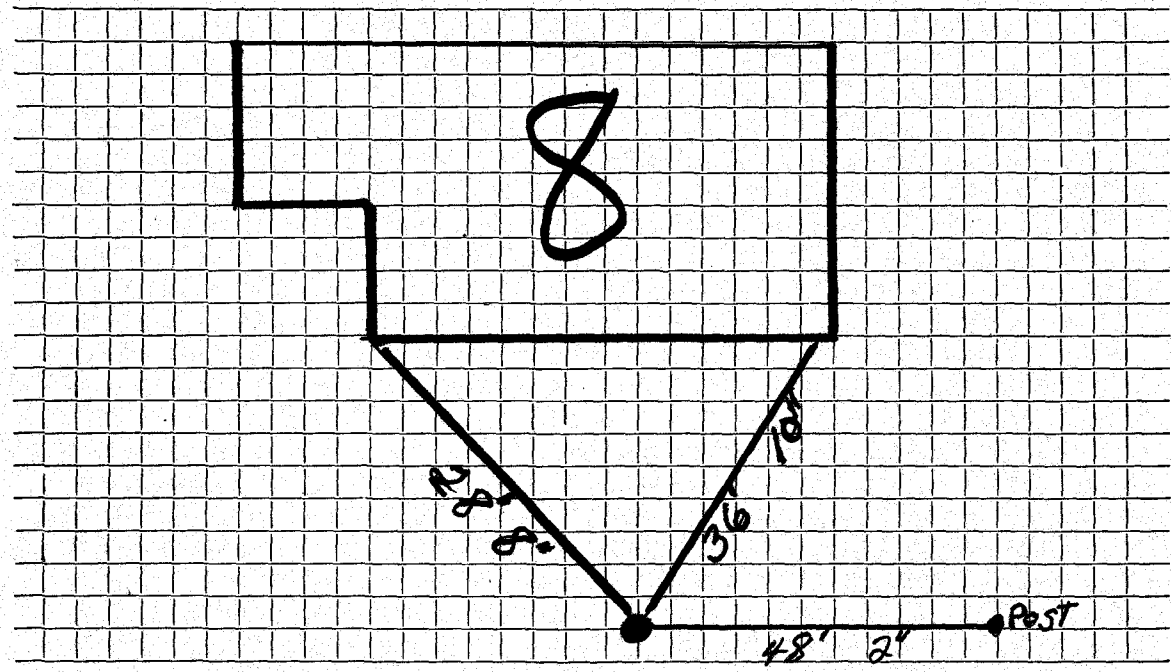

Connection made in Street. Work completed

Remarks:
.....
.....