




DATE 9-12-'90

TOWN OF LEXINGTON — BOARD OF PUBLIC WORKS

WATER DIVISION

Sketch of Service Here

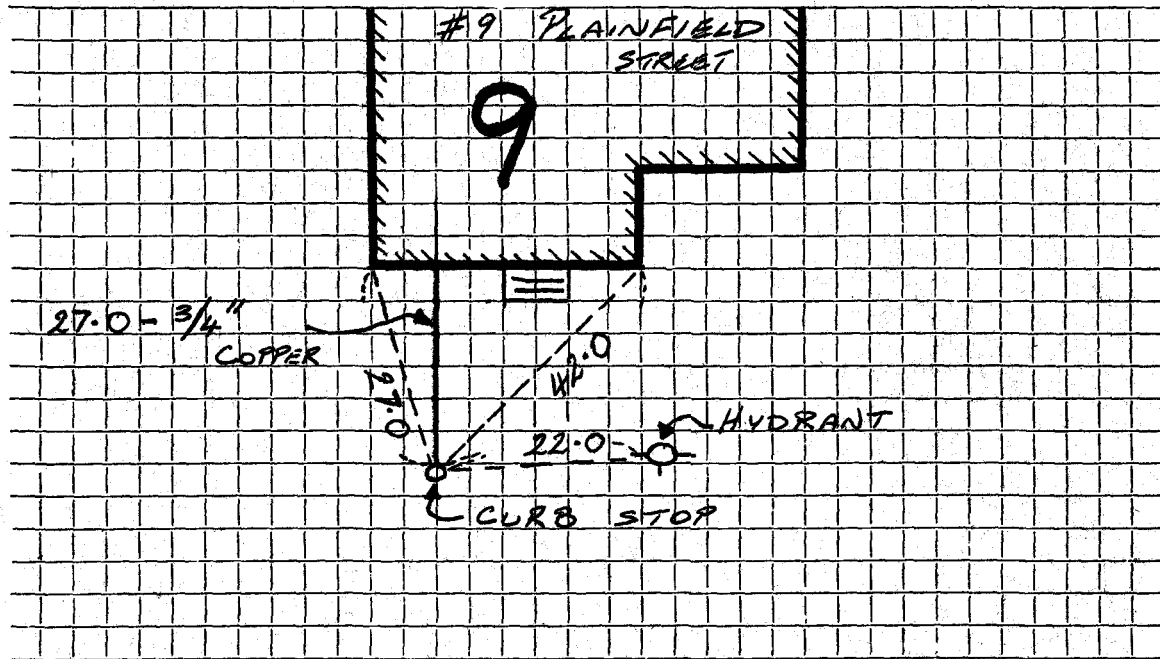

Connection made in PLAINFIELD Street. Work completed .....

Remarks: Service Corp. reamed out .....