

WATER SERVICE RECORD

Name

Service No.

Address 10 PLEASANT ST

Location

Repair—Renewal—New Service McLaughlin


Date	Material	Amount	Total	Date	Amount
10/98	1" COPPER 1 1/2" X 1" Tee 1" CURB 3 1" UNIONS BOX				
	TIED INTO EXIST 1.5" SERVICE				
1/4/2000	SERVICE TO GREEN HOUSE 58' 1.5 COPPER NO CURB.				

DATE _____

TOWN OF LEXINGTON — BOARD OF PUBLIC WORKS

WATER DIVISION

GREEN HOUSE JAN. 2000

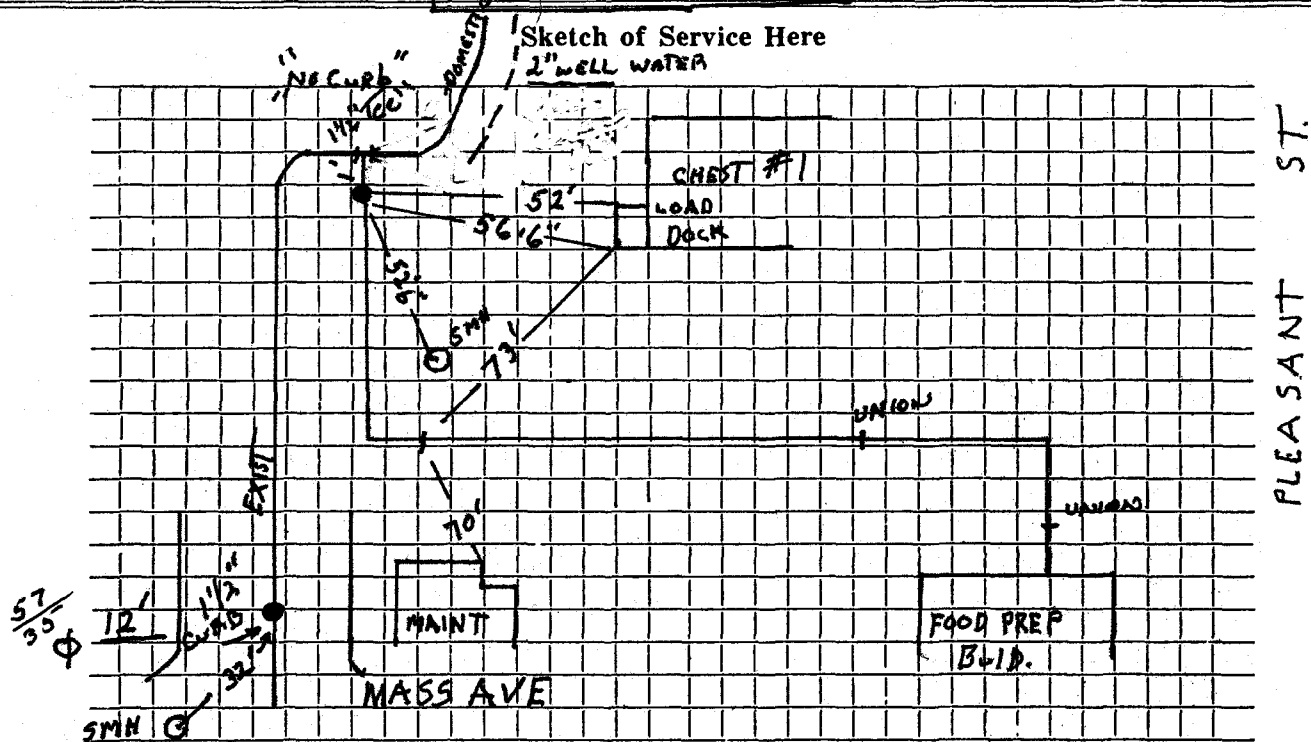


Connection made in PROPERTY Street. Work completed 10/98

Remarks: SEE PERMITS

TOWN OF LEXINGTON — BOARD OF PUBLIC WORKS

WATER DIVISION

Sketch of Service Here

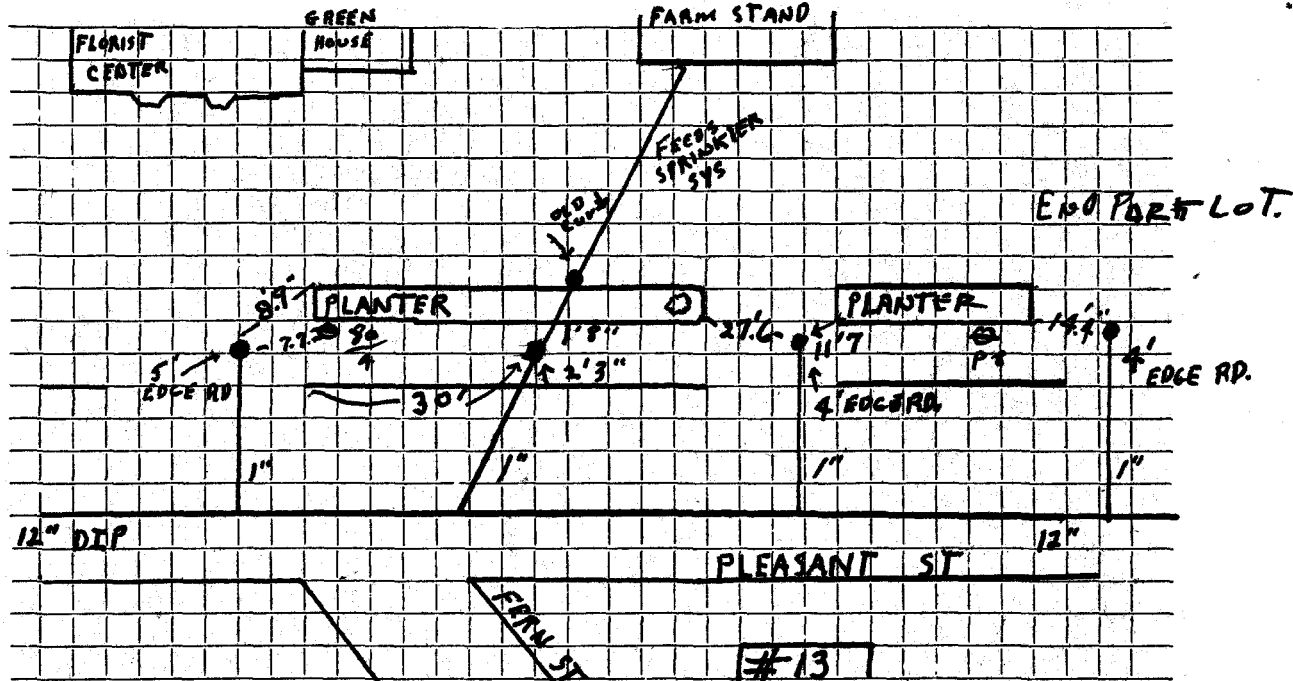

Connection made in 8-2-94 Street. Work completed

Remarks: DEFICIE CONT.

WATER SERVICE RECORD

Name Frank H. Strong

Service No. 157

Address 110 Pleasant Street

Location

#4655
#7496~~REPAIR RECORD~~ - New Service WO #7710

Comm 1-14-62


Date	Material	Amount	Total	Date		Amount
11-13-62	Labor	1.93		11-8-62	Deposit	175.00
	10% O.H.	.19	2.12	1-14-62	Refund	101.15
97	3/4" Copper tubing @.42		40.74			73.85
1	3/4" C x 1/2 I.W.H. Stop & Waste		6.17		NON CHARGE	
2	3/4" C 3 part unions @2.41		4.82	11-13-62	Labor	1.86
20	x 3 Patch		20.00	23	3/4" Copper tubing @.42	9.66
			73.85	1	3/4" C Corp Cock	4.91
				1	3/4" C Curb Cock	6.28
				1	Box & Rod	4.90
				1	1/2 Straight tailpiece	.50
				1	1/2 Offset tailpiece	.50
						<u>28.61</u>

~~Applied to S.H.C. #182~~

DATE _____

TOWN OF LEXINGTON — BOARD OF PUBLIC WORKS
WATER DIVISION

Sketch of Service Here

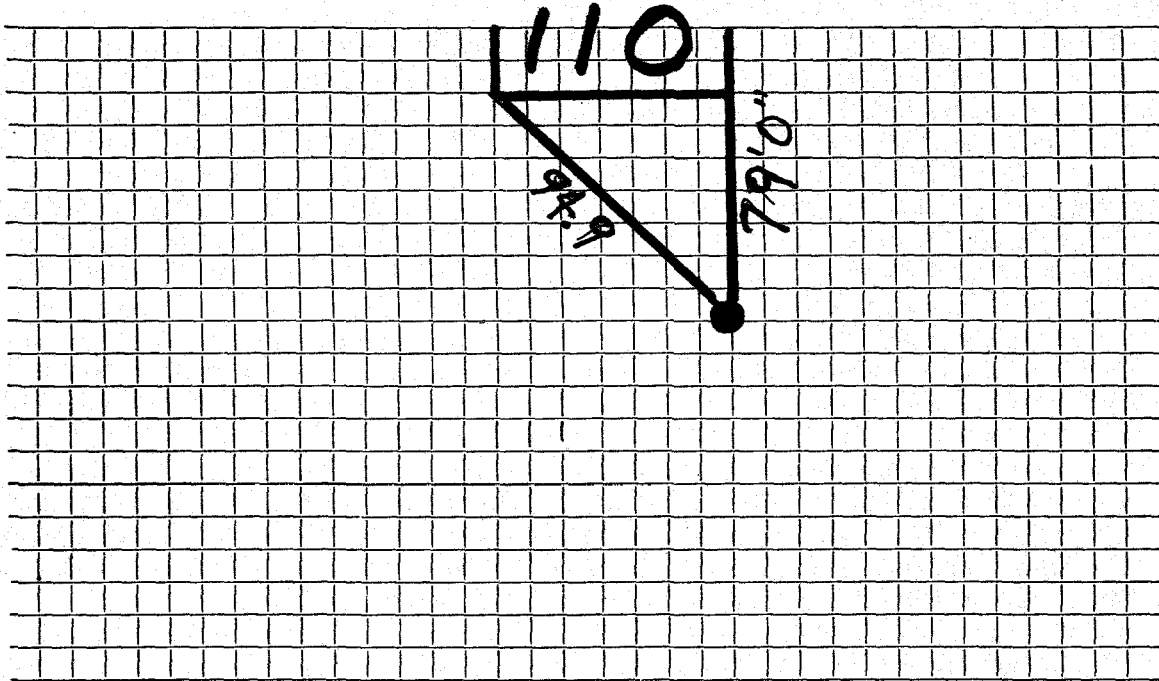

Connection made in Street. Work completed

Remarks:

.....

.....