

WATER SERVICE RECORD

1045

Name Robert Trebino

Service No. 66

Address 102 Pleasant Street

Location

~~Number~~ New Service W.O. #8073


Comm 10-28-63

Date	Material	Amount	Total	Date	Amount
8-1-63	Labor	5 74		7-18-63	Deposit 100 00
	10% O.H.	57	6 31	10-28-63	* Refund 63 52
	50' 3/4" Copper tubing @.42		21 00		36 48
	1 3/4" CX 1/2 I.W.H. Stop & Waste		6 17		
	1 Hr. Trucking @3.00		3 00		NON CHARGE
			36 48	8-1-63	Labor 44 57
					27' 3/4" Copper tubing @.42 11 34
					1 3/4" C Corp Cock 4 91
					1 3/4" C Curb Cock 6 28
					1 Box & Rod 4 90
					1 1/2 Straight Tailpiece 50
					1 1/2 Offset Tailpiece 50
					73 00
					* Applied 13.96 to SH #45

DATE _____

TOWN OF LEXINGTON — BOARD OF PUBLIC WORKS
WATER DIVISION

Sketch of Service Here

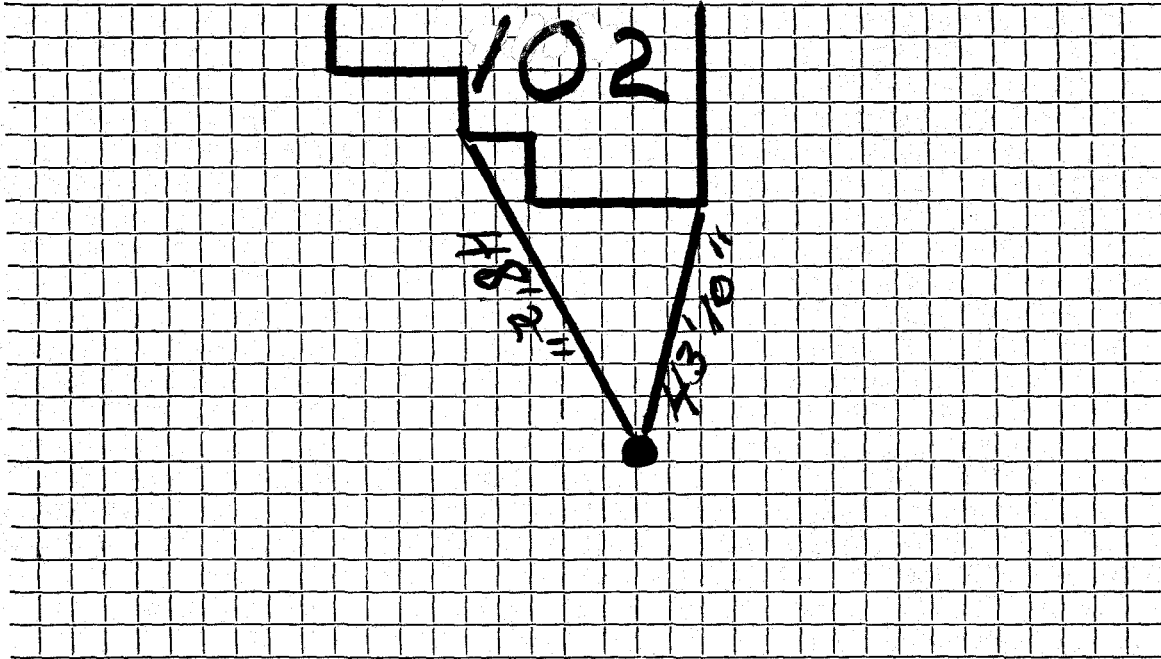

Connection made in Street. Work completed

Remarks:
.....
.....