

Name Stubbins

Service No. 50 3149

Address 103 Pleasant Street

Lexington, Mass.

Location 103 Pleasant Street

Kind of Pipe

Size

Size of Main

Repair—Renewal—New Service

Corr. 9-23-46

Location

Date	Material	Amount	Total	Date	Amount
July 20, '46	Labor	3 60	3 60	June 25, '46	75 00
	10% Overhead		36	Oct 10 '46	15 76
	204'-1" Copper Tubing @ .207		42.23		59 24
	1-1" C x $\frac{1}{4}$ " I.W.H. Stop & Waste	3 18		July 19, '46	25 37
	3-1" C x 1" X. Unions (3 parts)	3 12		8' - 1" Copper Tubing	1 66
	Patching 6' x 3'	6 00		1-1" C. Corp-cock	3 96
	Trucking 1 hr. @ .75		75	1-1" C x 1" C. Curb-cock	4 80
			59 24	1 \emptyset Box & Rod	1 65
				1 - $\frac{3}{4}$ " Offset Tail Piece	90
				1- $\frac{3}{4}$ " Straight Tail Piece	90
				Compressor 1 hr.	1 75
				Trucking 1 hr.	75
	Labor				41 74

Deposited
 Refunded
 Non-Charge

Hadley Press, Inc., Lexington

DATE _____

TOWN OF LEXINGTON—BOARD OF PUBLIC WORKS

WATER DIVISION

The undersigned applies for a supply of water at No. _____ St. and hereby agrees to comply with the rules and regulations as now, or at any future time, established by the Board of Selectmen.

Am't. of Estimate \$ _____


Owner _____

Am't. Paid \$ _____

Address _____

Builder _____

Sketch of Service Here

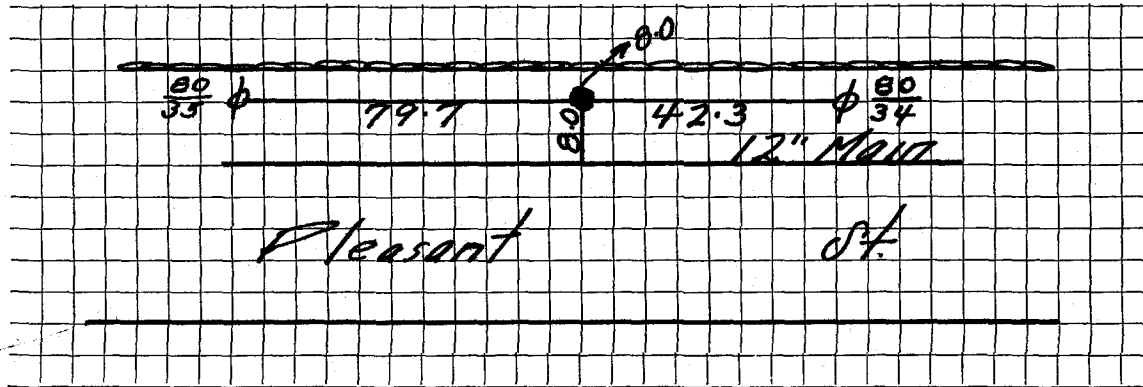

Connection made in _____ Street.

Work completed _____ 19

Remarks: