

Name Edscl Tocci

Service No. ⁵⁶ - 3294

Address 104 Pleasant Street

Lexington, Mass.

Location 104 Pleasant Street

Kind of Pipe

Size

Size of Main

~~Repair - Renewal~~ - New Service

Location

Date	Material	Amount	Total	Date	Location	Amount
Jul. 12, '47	Labor	22 16		July 7 '47	Deposited	63 00
Jul. 14, '47	"	9 29	31 45	Oct 14 '47	Paid	4 22
	10% Overhead		3 15		Non-Charge	59 22
	36' - 3/4" Copper Tubing @.27		9 72	Jul. 14, '47	Labor	58 67
	1 - 3/4" C x 1/2" I.W.H. S & W		3 15	15	"	17 73
	Patching 11 x 3		11 00	16' - 3/4" Copper Tubing @.27		4 32
	Trucking 1 hr. @.75		75	1 - 3/4" C Corp-cock		3 00
			59 22	1 - 3/4" C x 3/4" C Curb-cock		3 68
				1 - Box & Rod		4 26
				1 - 1/2" Straight Tail Piece		30
				1 - 1/2" Offset Tail Piece		30
				Compressor 8 hrs. @1.75		14 00
				Trucking 1 hr. @ .75		75
						107 01

Bill sent 9-16-47

Labor

TOWN OF LEXINGTON—BOARD OF PUBLIC WORKS

WATER DIVISION

The undersigned applies for a supply of water at No. _____ St. and hereby agrees to comply with the rules and regulations as now, or at any future time, established by the Board of Selectmen.

Am't. of Estimate \$ _____

Owner _____


Am't. Paid \$ _____

Address _____

Builder _____

E Lowell Avenue
Watutown - Mass

Sketch of Service Here

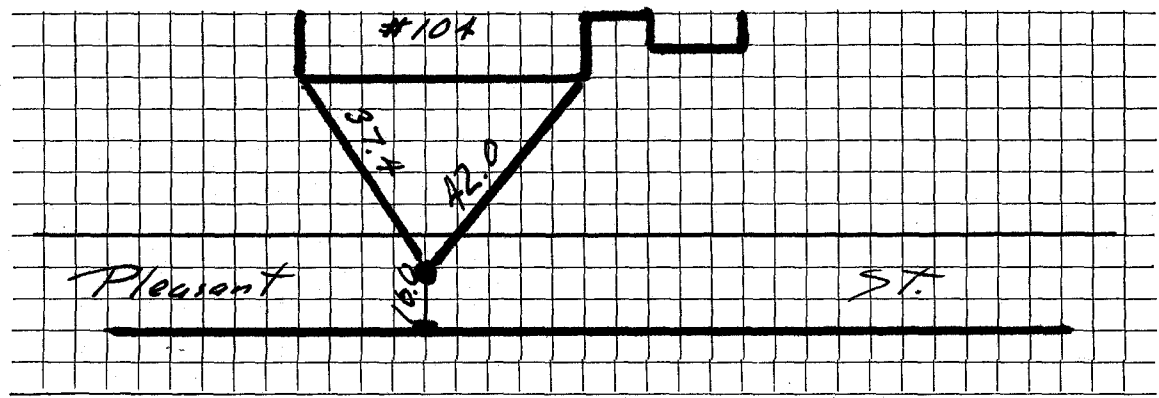

Connection made in _____ Street.

Work completed _____ 19

Remarks: