

## WATER SERVICE RECORD

373/

Name Frank R. Strong

Service No. 4

Address 106 Pleasant Street

Location

~~REPAIR WORK~~—New Service

W.O.# 7027

Comm 2-26-62


Date	Material	Amount	Total	Date	Amount
1/17/18/62	Labor	215 91		12-29-61	Deposit 150 00
	10% O.H.	21 59	237 50	3-20-62	Paid 221 37
	60' 3/4" Copper Tubing @ .42		25 20		371 37
	1 3/4" Cx 1/2 IWH Stop & Waste		6 17		
	6 Hrs. Compressor @ 3.00		18 00		
	5 Hrs. Town Shovel @ 6.50		32 50		Curb to Main
	4 Hrs. Trucking @ 3.00		12 00		21' 3/4" Copper Tubing @ .42 8 82
	4 Hrs. Teeth @ 6.25		25 00		1 3/4" C Corp Cock 4 91
	15 X 3 Patch		15 00		1 3/4" C Curb Cook 6 28
			371 37		1 Box & Rod 4 90
					1 1/2 Straight Tailpiece 50
					1 1/2 Offset Tailpiece 50
					25 91

Bill sent 221.37

DATE \_\_\_\_\_

TOWN OF LEXINGTON — BOARD OF PUBLIC WORKS  
**WATER DIVISION**

Sketch of Service Here

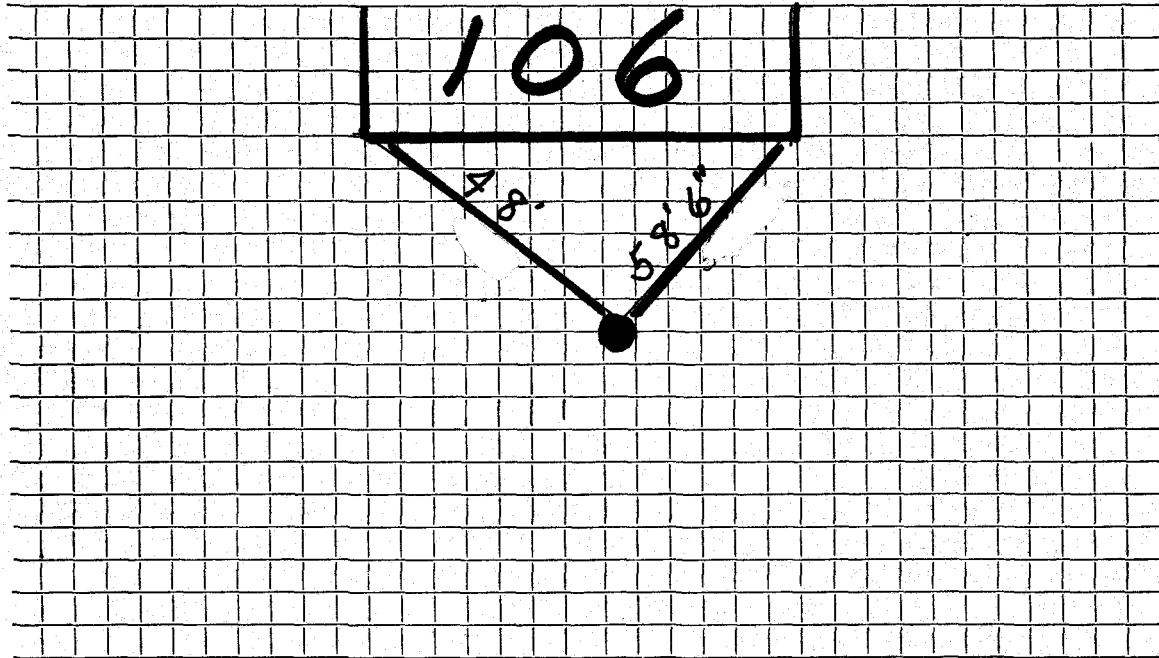

Connection made in ..... Street.                      Work completed .....

Remarks: .....  
.....  
.....