

Name Edsel Tocck

Service No. ⁵⁷

3295

Address 108 Pleasant Street

3487

Lexington, Mass.

Location 108 Pleasant Street

Kind of Pipe

Size

Size of Main

~~Repair—Renewal—New Service~~

Location

Date	Material	Amount	Total	Date	Location	Amount
Jul. 11, '47	Labor	29 14		July 9 '47	Deposited	60 00
12	" 2	5 49	34 63	Oct 14 '47	Paid	5 14
	10% Overhead		3 46		Non-Charge	65 14
	45' - 3/4" Copper Tubing @.27		12 15	Jul. 11, '47	Labor	16 46
	1 - 3/4" C x 1/2" I.W.H. S & W		3 15	12	"	15 40
	Patching 11 x 3		11 00	17' - 3/4" Copper Tubing @.27		4 59
	Trucking 1 hr. @.75		75	1 - 3/4" C Corp-cock		3 00
			65 14	1 - 3/4" C x 3/4" C Curb-cock		3 68
				1 - 3/4" C x 3/4" C Union 3 pts.		1 32
				1 - Box & Rod		4 26
				1 - 1/2" Offset Tail Piece		30
				1 - 1/2" Straight Tail Piece		30
				Compressor 6 hrs. @2.75		16 50
				Trucking 1 hr. @.75		75
						66 56

Bill sent 9-16-47

Labor

Hadley Press, Inc., Lexington

DATE _____

TOWN OF LEXINGTON—BOARD OF PUBLIC WORKS

WATER DIVISION

The undersigned applies for a supply of water at No. _____ St. and hereby agrees to comply with the rules and regulations as now, or at any future time, established by the Board of Selectmen.

Am't. of Estimate \$ _____


Owner _____

Am't. Paid \$ _____

Address _____

Builder _____

Sketch of Service Here

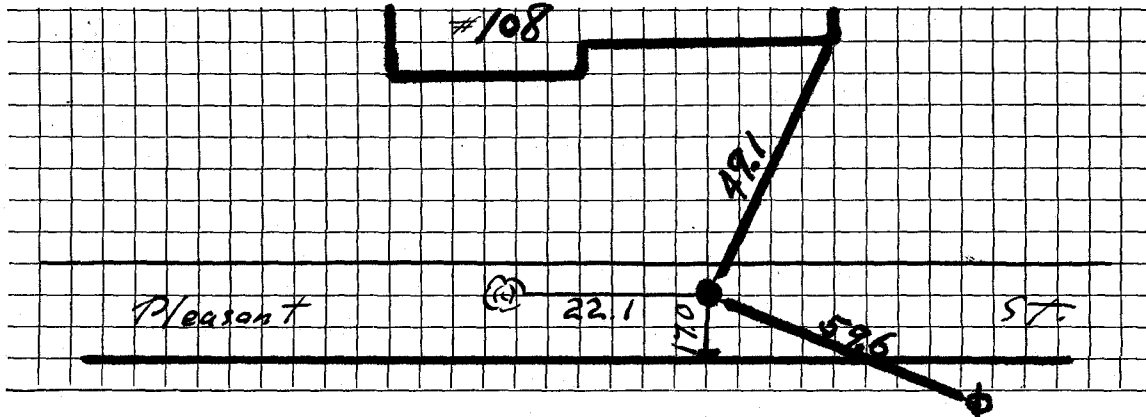

Connection made in _____ Street.

Work completed _____ 19

Remarks: