

WATER SERVICE RECORD

Name

Service No.

Address 11 + 13 PLEASANT ST.

Location

Repair - Renewal - New Service


Date	Material	Amount	Total	Date		Amount
					NON - CHARGE	
					15' - 3/4" Copper Tubing @ 2.55	3.83
					1 - 3/4" C CORB - COCK	3.00
					1 - 3/4" C X 3/4" I CORB - COCK	3.68
						10.51

DATE _____

TOWN OF LEXINGTON — BOARD OF PUBLIC WORKS

WATER DIVISION

Sketch of Service Here

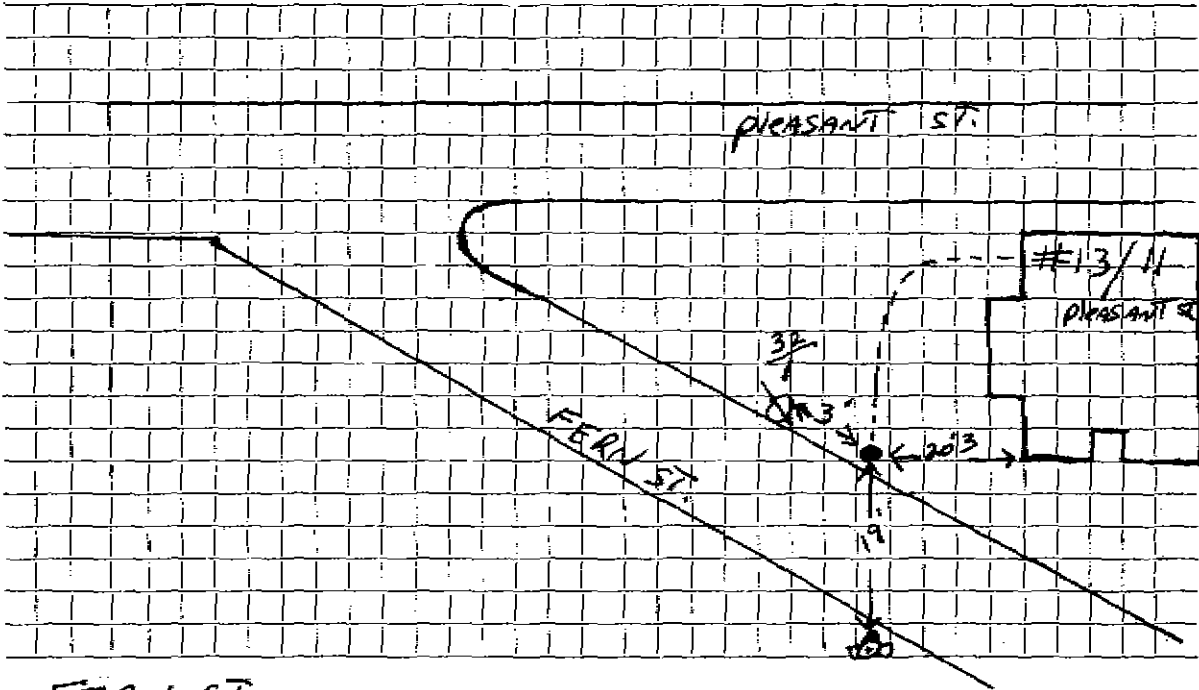

Connection made in FERN ST. Street. Work completed

Remarks:
.....
.....