

WATER SERVICE RECORD

Name Charles M. Willis

Service No. 161

Address 112 Pleasant Street

Location

~~REPAIR WORK~~ - New Service

*Com. F-30-54*


Date	Material	Amount	Total	Date	Amount
7/29/54	Labor	3 70		7-8-54 Deposited	75 00
	10% overhead	37	4 07	8-30-54 Refunded	(17 46)
	70' - 3/4" copper tubing @ .35		24 50		<u>NON CHARGE</u>
	1 - 3/4"C x 1/2 I.W.H. stop & waste	4 00		7/29/54 Labor	14 82
	1 - 3/4"C union		1 72	28' - 3/4" copper tubing @ .35	9 80
	1 hr. Littlefield shovel		7 50	1 - 3/4"C. corp-cock	4 33
	1 hr. trucking		75	1 - 3/4" curb-cock	4 67
	patching 15 x 3		15 00	1 box and rod	3 90
			57 54	1 - 1/2 straight tail piece	50
	PART OF TRENCH DUG BY OWNER:			1 - 1/2 offset tail piece	50
				2 2/3 hrs. Littlefield shovel	
				@ 7.50	20 00
				1 hr. trucking	75
					<u>59 27</u>

DATE \_\_\_\_\_

TOWN OF LEXINGTON — BOARD OF PUBLIC WORKS

WATER DIVISION

Sketch of Service Here

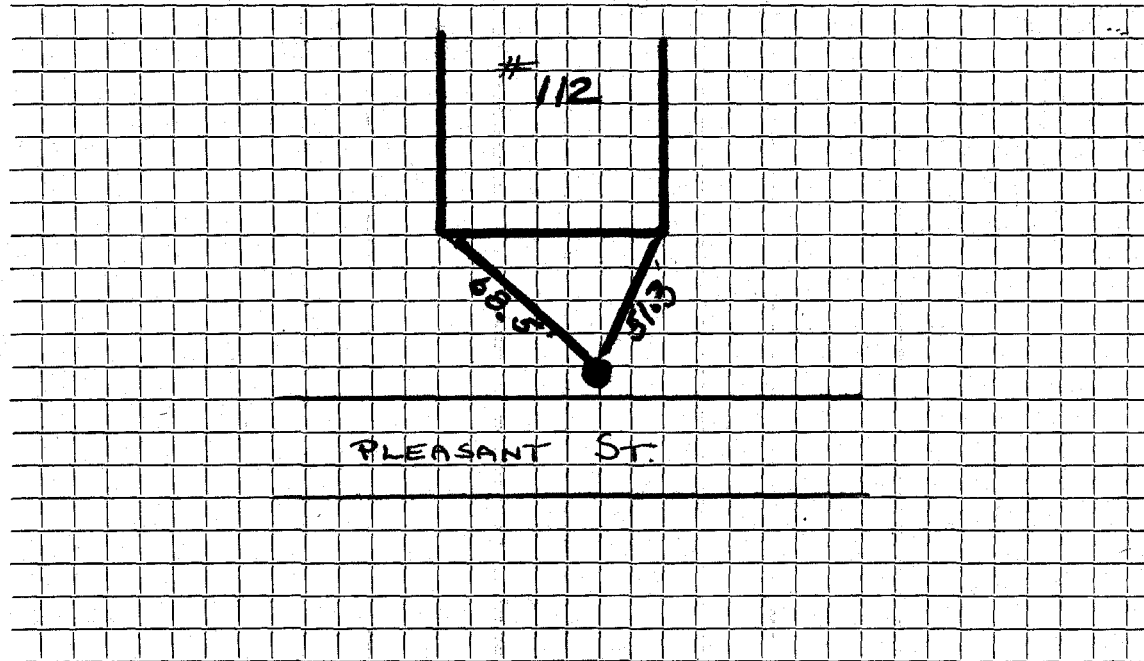

Connection made in ..... Street.      Work completed .....

Remarks: .....

.....

.....