

WATER SERVICE RECORD

Name Barbara Duncan

Service No. 61

Address 114 Pleasant Street

Location Lexington, Mass.

Reported - New Service

Com. 8-6-51


Date	Material	Amount	Total	Date	Material	Amount
4/30/51	Labor	10 00	10 00	4-13-51	Deposited	60 00
	10% overhead		1 00			
	55' - 3/4" copper tubing @ .36		19 80		No charge	
	1 - 3/4" C x 1/2 I.W.H. stop & waste		4 00	4/30/51	Labor	27 27
	1 hr. littlefield shovel		7 00		26' - 3/4" copper tubing @ .36	9 36
	1 hr. trucking		75		1 - 3/4" C. corp-cock	4 33
	patching 15 x 3		15 00		1 - 3/4" C x 3/4" C. curb-cock	4 67
			57 55		1 - box and rod	4 68
					1 - 1/2 offset tail piece	50
					1 - 1/2 straight tail piece	50
					2 hrs. Littlefield shovel	7.00
					1 hr. trucking	14 75
						66 06

DATE _____

TOWN OF LEXINGTON — BOARD OF PUBLIC WORKS

WATER DIVISION

Sketch of Service Here

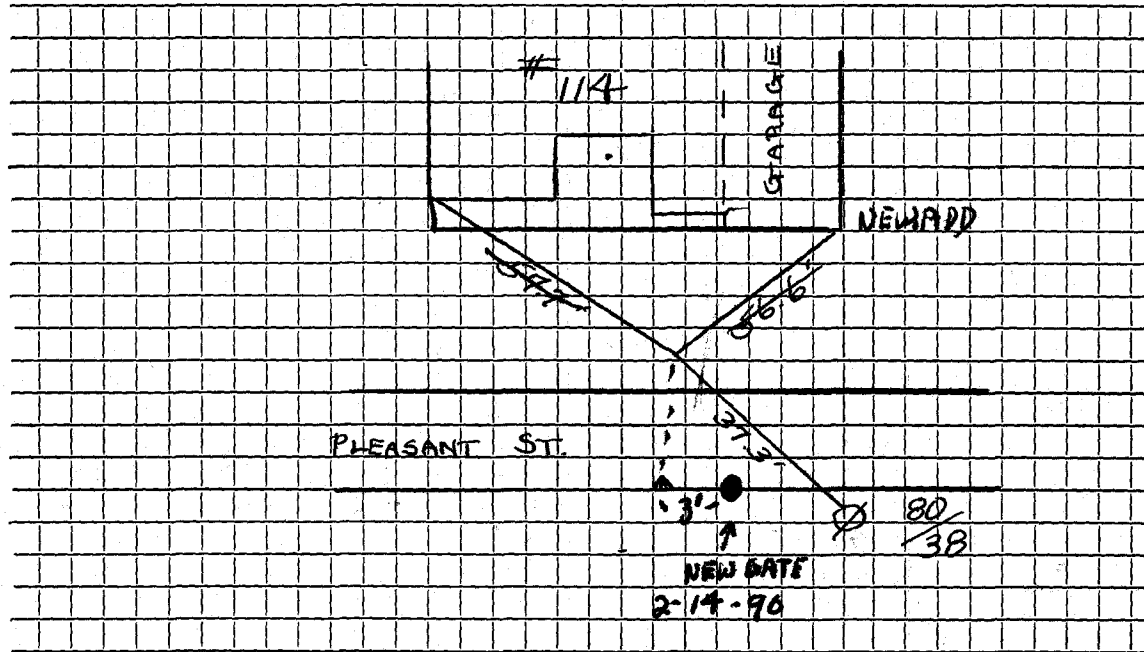

Connection made in Street. Work completed

Remarks:

.....
.....