

WATER SERVICE RECORD

Name Alfred Colella

Service No. 168

Address 116 Pleasant Street

Location Lexington

~~Repair-Renovation~~ New Service

Com. 9-29-52


Date	Material	Amount	Total	Date	Amount
9/11/52	Labor	3 14		8-11-52 Deposited 10-7-52 Paid	60 00
	10% Overhead	31	3 45		22
	70' - 3/4" Copper tubing @ .34		23 80		60 22
	1-3/4" C x 1/2" I.W.H. stop & waste		4 00		
	1-3/4" C x 3/4" C. union 3 pts.		1 72		
	1 hr. Littlefield shovel		7 00	9/11/52 Labor	8 94
	1 hr. trucking		75	30' - 3/4" Copper tubing @ .34	10 20
	patching 20 X 3		20 00	1 - 3/4" C. corp-cock	4 33
			60 72	1-3/4" C x 3/4" C. curb-cock	4 67
				1 box and rod	3 90
				1 - 1/2" offset tail piece	50
				1 - 1/2" straight tail piece	50
				3 hrs. Littlefield shovel	21 00
				1 hr. trucking	75
					54 79

bill sent 9-29-52

TOWN OF LEXINGTON — BOARD OF PUBLIC WORKS

WATER DIVISION

Sketch of Service Here

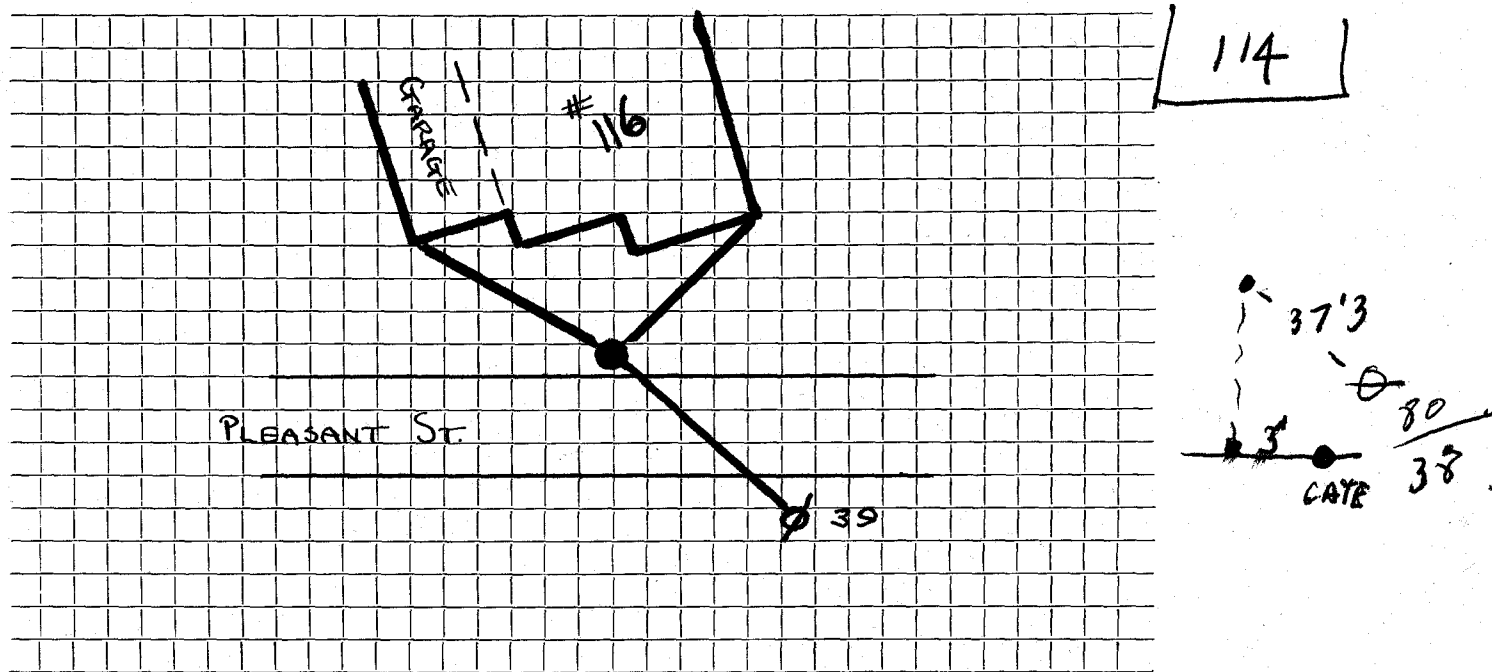

Connection made in Street. Work completed

Remarks:
.....
.....