


DATE 7/19/95

TOWN OF LEXINGTON — BOARD OF PUBLIC WORKS

WATER DIVISION

Sketch of Service Here

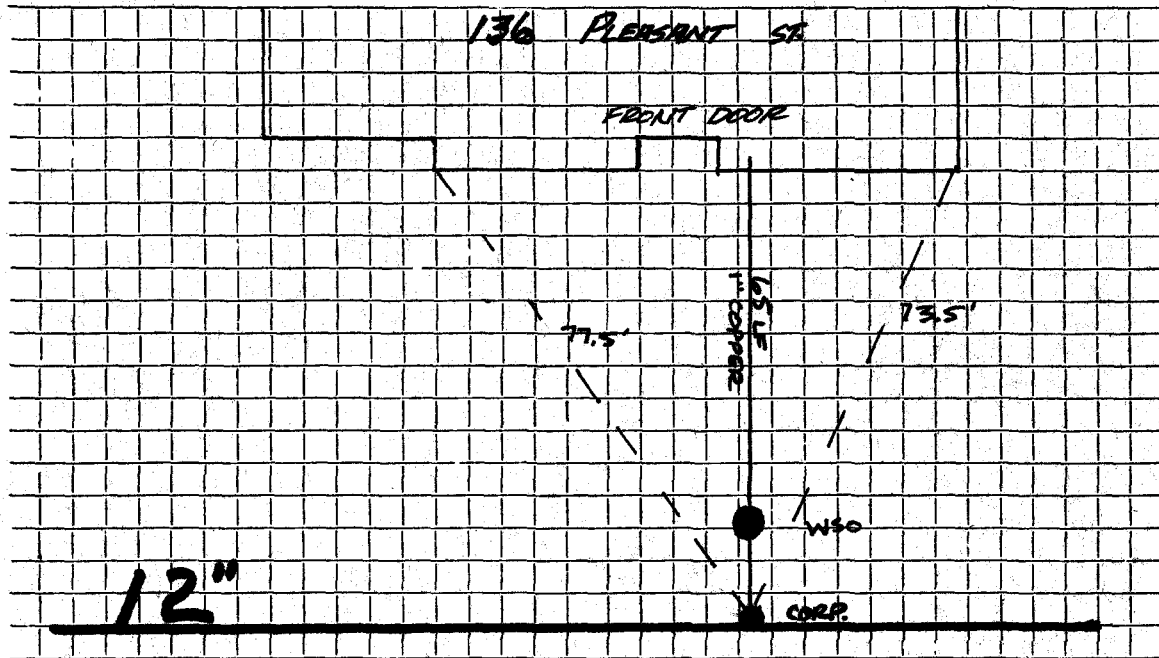

Connection made in PLEASANT Street. Work completed .. PAVING

Remarks:

.....

.....