


Date: Nov 2022

TOWN OF LEXINGTON - BOARD OF PUBLIC WORKS
WATER DIVISION

SKETCH OF SERVICE HERE
141 Pleasant St

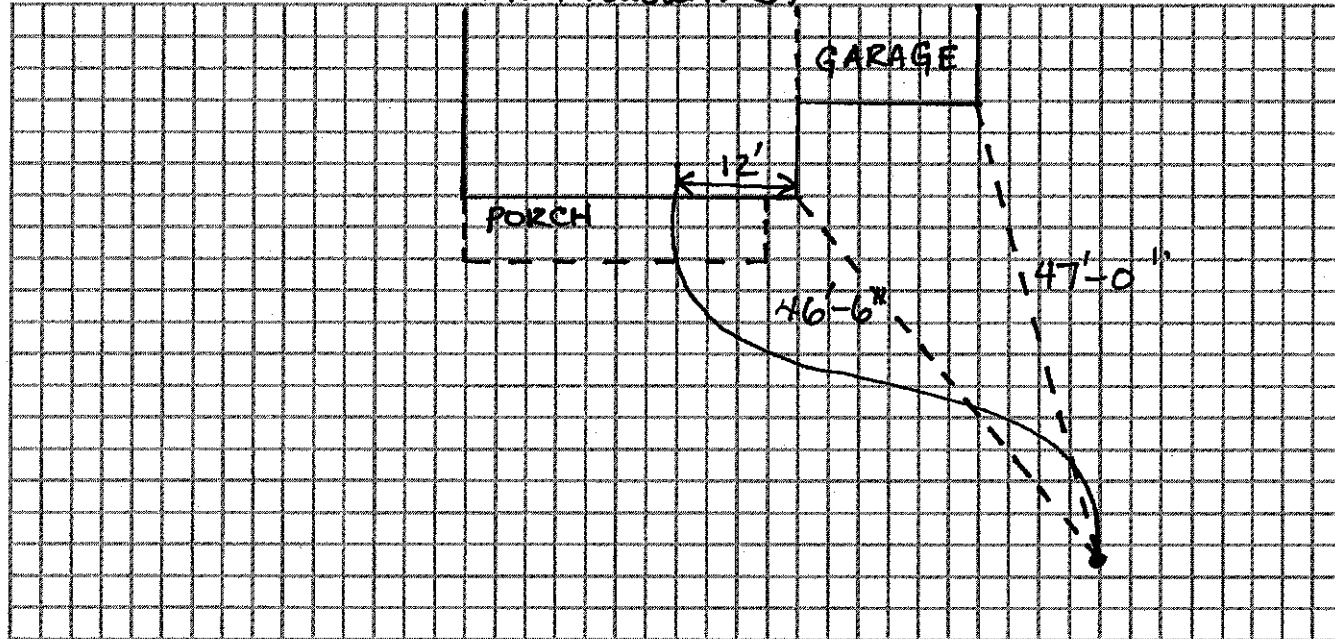

Connection made in:

Street:

Work completed:

Remarks: Installed by S & T Frotton Inc.