




DATE 8/3/94

TOWN OF LEXINGTON — BOARD OF PUBLIC WORKS

**WATER DIVISION**

Sketch of Service Here

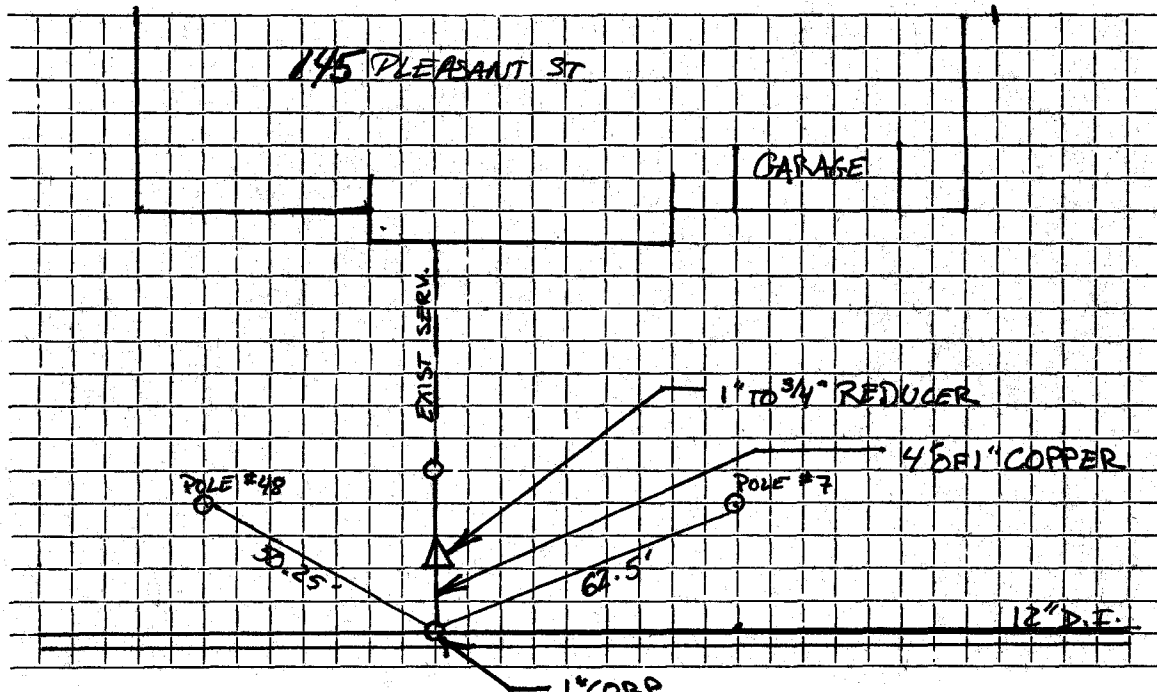

Connection made in ..... Street. 5' DOWN Work completed .....

Remarks: .....

.....

.....