

WATER SERVICE RECORD

Name

Service No.

Address 148 PLEASANT STREET

Location

Repair—Renewal—New Service RENEWAL


Date	Material	Amount	Total	Date	Material	Amount
8/3	94 Outside					
	5' OF 1" COPPER					
	1-1" X 3/4" REDUCER					
	1 1" C. Comp Cock			5-10-	52 Inside	
	17' 3/4" Copper				44' 3/4" Copper	
	1 3/4" C. X 3/4" C. Curb Cock				1 3/4" C. X 1/2" I. W. H. Stop + Waste	
	1 Box + Rod					

DATE 8/3/94

TOWN OF LEXINGTON — BOARD OF PUBLIC WORKS

WATER DIVISION

Sketch of Service Here

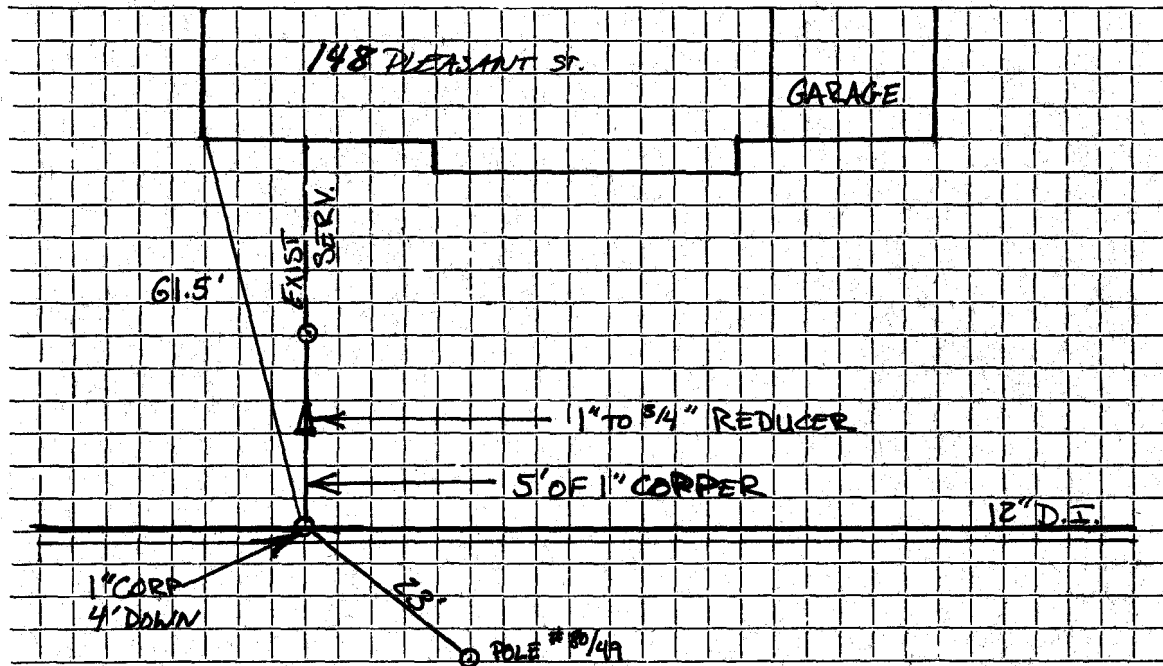

Connection made in Street. Work completed

Remarks:
.....
.....