

Name Raymond Detrick
 Address 15 Pleasant Street
 Lexington, M s s.

Service No.

Location 15 Pleasant Street + 10 FERN ST.

Kind of Pipe Size Size of Main

~~Repair~~ - Renewal - ~~New Service~~ Renewed to 12" main from Fern St. Location

Date	Material	Amount	Total	Date	Amount
					No Charge
				Oct. 15, '48	Labor 1 15
				21' - 3/4"	Copper Tubing @.255 5 36
				1 - 3/4" C	Worp-cock 3 00
				1 - 3/4" C	x 3/4" C Curb-cock 3 68
				1 - Box & Rod	3 55
				2 - 1/2" Offset Tail Pieces	60
					<hr/>
					17 34
	Labor				

DATE _____

TOWN OF LEXINGTON - BOARD OF PUBLIC WORKS

WATER DIVISION

The undersigned applies for a supply of water at No. St. and hereby agrees to comply with the rules and regulations as now, or at any future time, established by the Board of Selectmen.

Am't of Estimate \$.....


Owner

Am't Paid \$.....

Address

Builder

Sketch of Service Here *Pleasant St.*

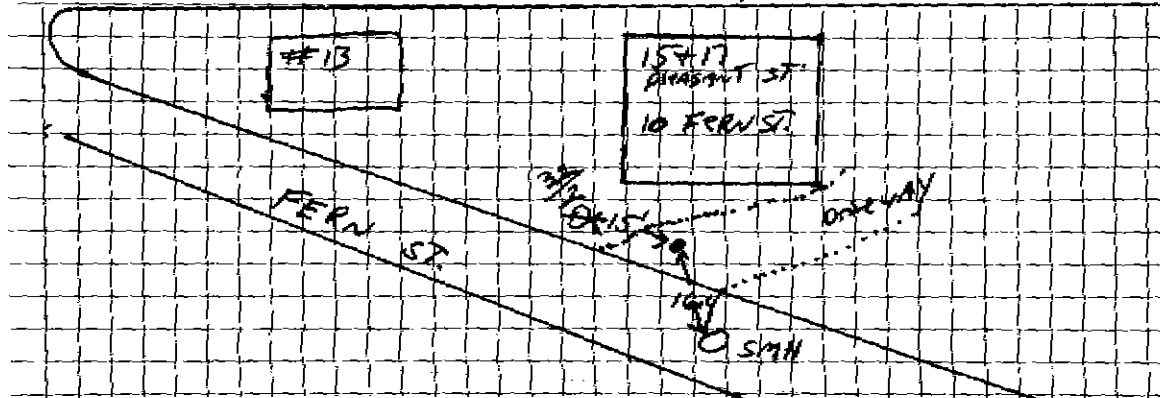

Connection made in *FERN ST.* Street.

Work completed19

Remarks: