

WATER SERVICE RECORD

Name

Service No.

Address 159 PLEASANT STREET

Location

Repair—Renewal—New Service RENEWAL


Date	Material	Amount	Total	Date	Material	Amount
8 94	4' OF 1" COPPER					
	1-1" x 3/4" REDUC.					
	1 1" C. Corp Cock			10-19-60	Inside	
10-19-60	14' 3/4" Copper			68'	3/4" Copper	
	1 3/4" C. Curb Cock				1 3/4" C. X 1/2" I.W.H. Stop + Waste	
	1 Box + Rod				1 3/4" C. - 3 Part Union	

DATE 8/94

TOWN OF LEXINGTON — BOARD OF PUBLIC WORKS

WATER DIVISION

Sketch of Service Here

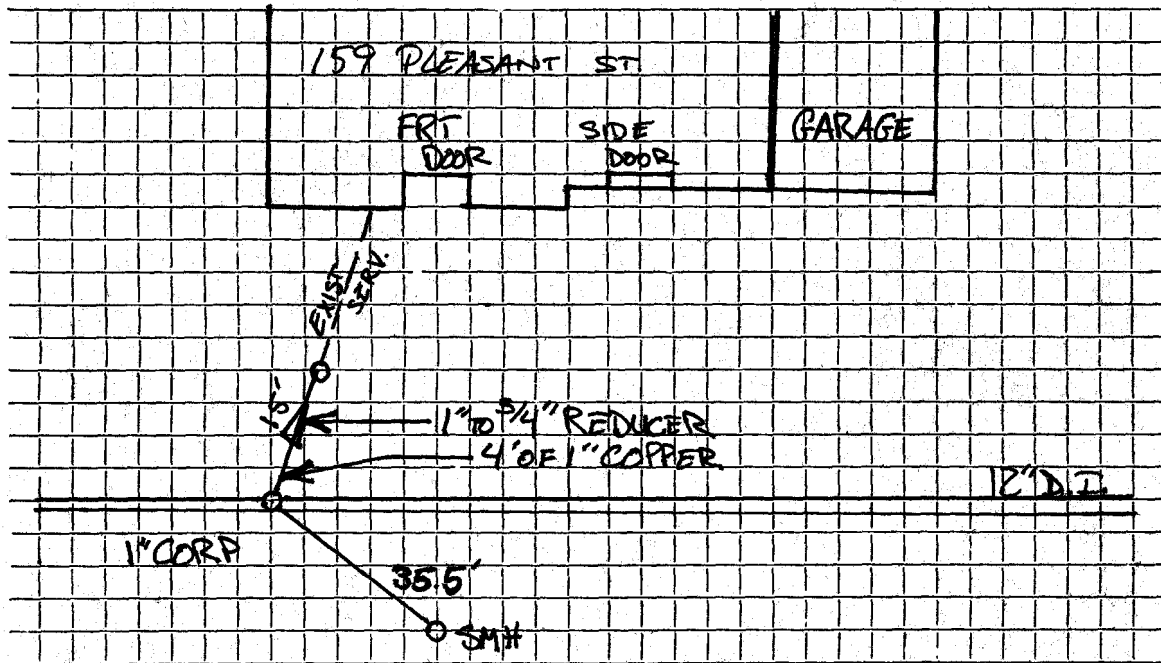

Connection made in Street. Work completed

Remarks:

.....

.....