

WATER SERVICE RECORD

Name Alan B. Wilson

Service No. 324

Address 23 Pleasant Street

Location

~~Repair/Alter~~ New Service


Comm 2-29-60

Date	Material	Amount	Total	Date	Amount	
12-20-59	Labor	31.95		12-7-59	Deposit	200.00
12-23-59	" "	36.16	68.11	2-29-60	Refund	46.58
	10% O.H.	6.81	74.42			15.34
105'	3/4" Copper tubing@.42		44.10			
1	3/4" Cx 1/2 I.W.H. Stop & Waste		5.88		NON CHARGE	
1	3/4" C3 Part Union		2.27	12-21-59	Labor	3.24
3	Hrs. Town shovel@6.50		19.50	5'	3/4" Copper tubing@.42	2.10
	5 x 3 Patch		5.00	1	3/4" C Corp Cock	4.67
3	Hrs. Trucking@.75		2.25	1	3/4" C Curb Cock	5.98
			153.42	1	Box & Rod	5.00
				1	1/2 Straight tailpiece	.50
				1	1/2 Offset tailpiece	.50
				1	Hr. Town shovel@6.50	6.50
				1	Hr. Trucking@.75	.75
						29.24

TOWN OF LEXINGTON — BOARD OF PUBLIC WORKS

WATER DIVISION

Sketch of Service Here

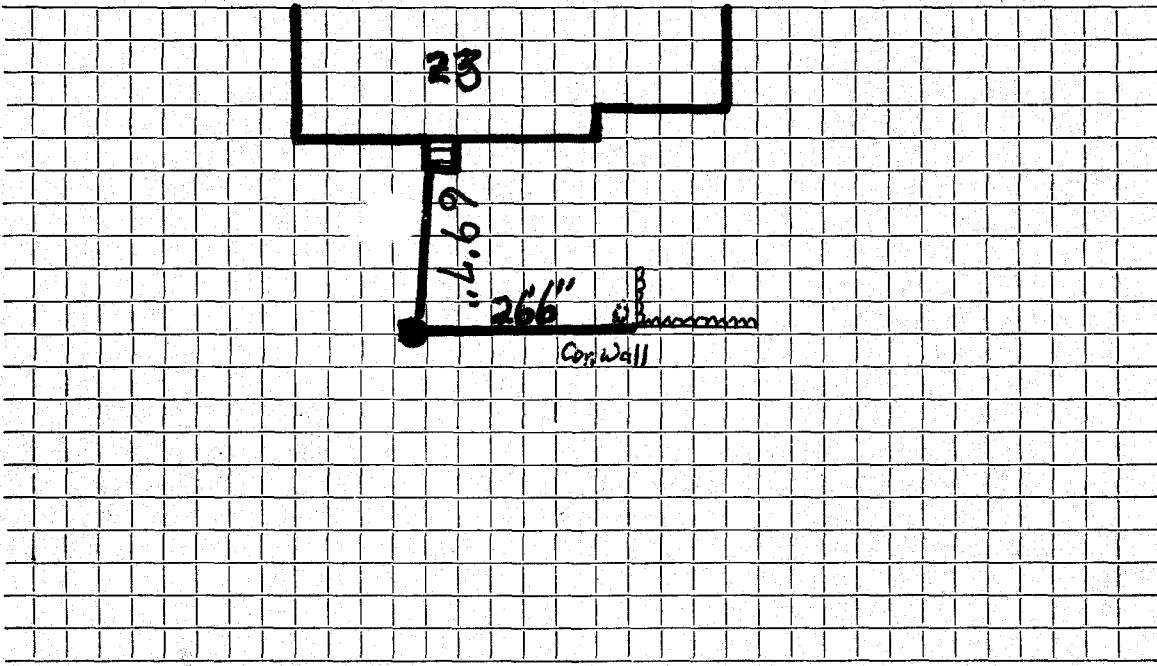

Connection made in Street. Work completed

Remarks:
.....
.....