


TOWN OF LEXINGTON - BOARD OF PUBLIC WORKS
 WATER DIVISION

Date: 6/20/01

SKETCH OF SERVICE HERE

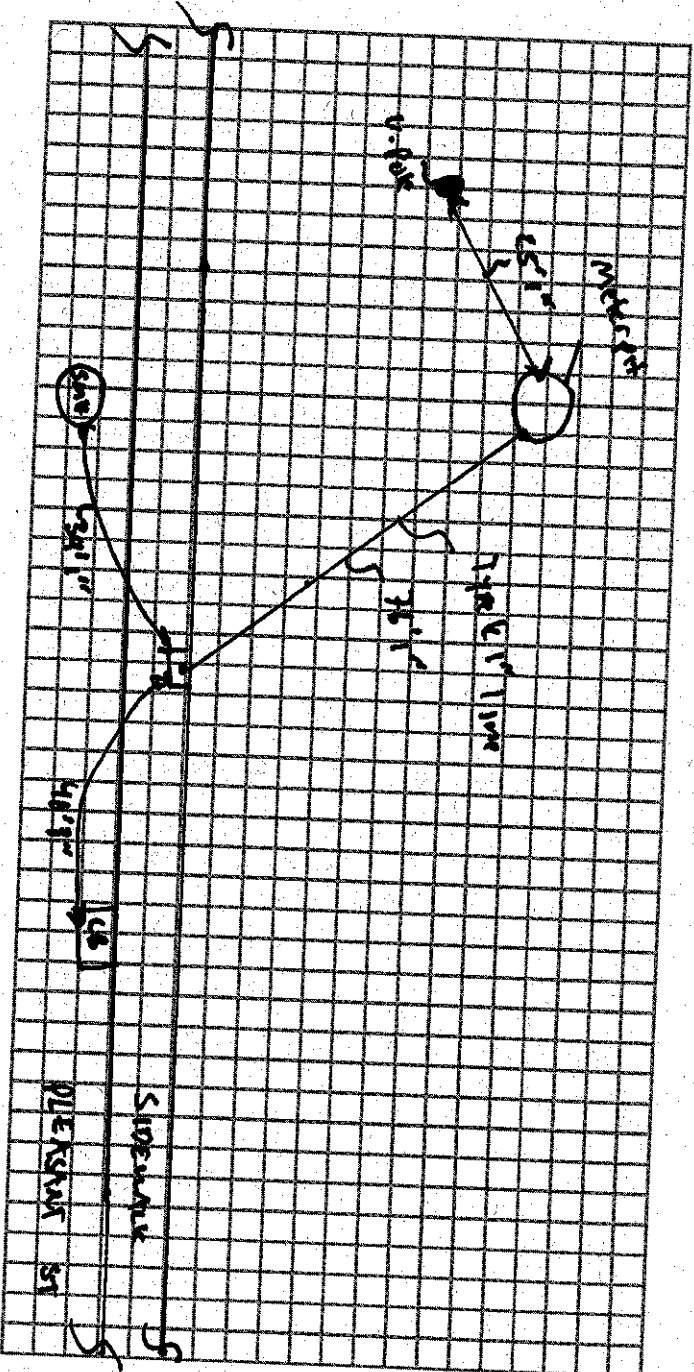

Connection made in: Pleasant

Remarks:

Street:

Work completed:

Address 29 Pleasant

Location

Repair - Renewal New Service

Date	Material	Amount	Total	Date		A
6/2011	1" C.S. & Gal. Box	(1)				
	(existing)					
	Type 1" copper	76'				
	Com. Meter pit	(1)				

Name James E. Wilson #29

Service No. # 2245

Address Lot 35, Pleasant St.

Location

Kind of Pipe

Size

Size of Main

~~Repair - Renewal~~ - New Service

Location

Date	Material	Amount	Total	Date	Amount
11/24/31 P. 12-22-31 for 4.80	1 1" CtoC Union	1 00			
	1 1" CtoI Ell	80			
	1 S & W	3 00	\$4 80	Feb 2 1932 - Cash	4 80
	Labor				

Hadley Preks, Inc., Lexington

DATE Nov. 1, 1931.

TOWN OF LEXINGTON—BOARD OF PUBLIC WORKS

WATER DIVISION

Lot #29

The undersigned applies for a supply of water at No. 35 Pleasant St. and hereby agrees to comply with the rules and regulations as now, or at any future time, established by the Board of Selectmen.

Am't. of Estimate \$ _____

Owner


James E. Wilson By

Am't. Paid \$ _____

Address

*27 Pleasant St. N.W.
Lexington*

Builder _____

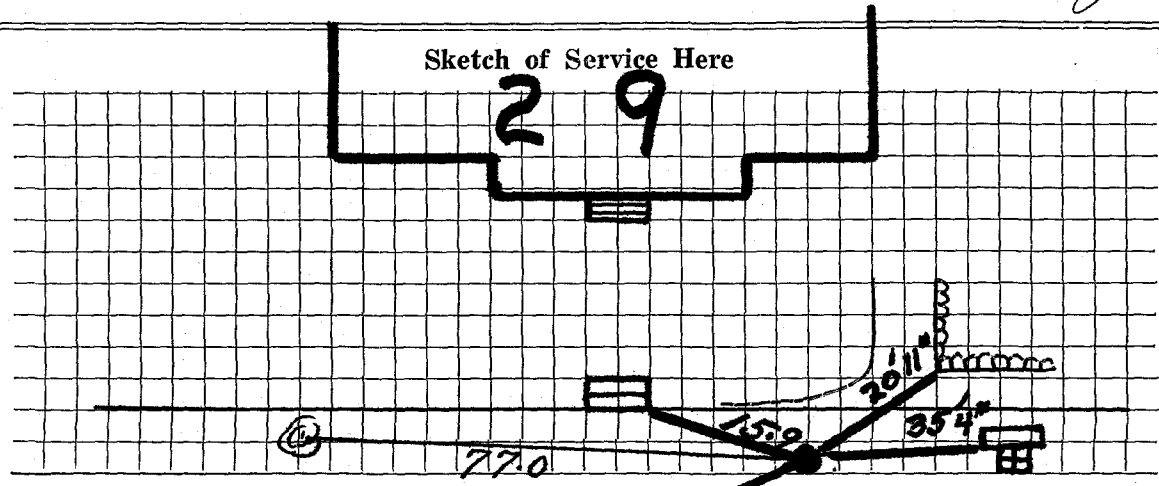

Connection made in _____

Street.

Work completed _____

19

Remarks: