

Name *Isabelle J. Cummings*
 Address *46 Pleasant St.*

Service No. *2234*
 # *4000*

Location *4 Pleasant St.*
 Size *6*

Kind of Pipe _____ Size _____ Size of Main _____

Repair—Renewal—New Service W.O. # *6694* Location _____

Date	Material	Amount	Total	Date	Material	Amount
	Main to Curb				Main to curb	
5/10/68	Labor	\$54 53				
5/13/68	"	\$24 20				
		<u>\$78 73</u>				
	10% O.H.	7 87	\$86 60		Relocate Service from 6" to 12"	
10'	3/4" copper	@.79	\$7 90	7/5/27/30/79	Main W.O. #0562	
1	3/4" adapt.		\$2 76		Labor	
1	3/4" Curb Stop		\$11 32	12'	3/4" Copper	
1	1" Clamp		\$5 05	1	3/4" 3 Port Union	
1	1"x6" Nipple		65	1	3/4" Corp.	
1	Lead Cuppling		60	1 1/2	Gravel	
1	Box and Rod		\$5 10	9	Hrs. Trucking	
5/13/68	1 Ton Hot Top		\$5 50	2	Hrs. Case	
	Labor		\$125 48	1	Hr. Roller	
	3 hrs. Trucking @3.00		\$9 00	1	Hr. Comp.	
	21/2 hrs. Tractor @6.50		\$16 25		6' X 17' Patching	
			<u>\$150 73</u>			

Hadley Press, Inc., Lexington

DATE _____

TOWN OF LEXINGTON—BOARD OF PUBLIC WORKS

WATER DIVISION

The undersigned applies for a supply of water at No. _____ St. and hereby agrees to comply with the rules and regulations as now, or at any future time, established by the Board of Selectmen.

Am't. of Estimate \$ _____

Owner

J. Alexander Wilson

Am't. Paid \$ _____


Address

4 Pleasant St.

Builder _____

*27
6*

Sketch of Service Here

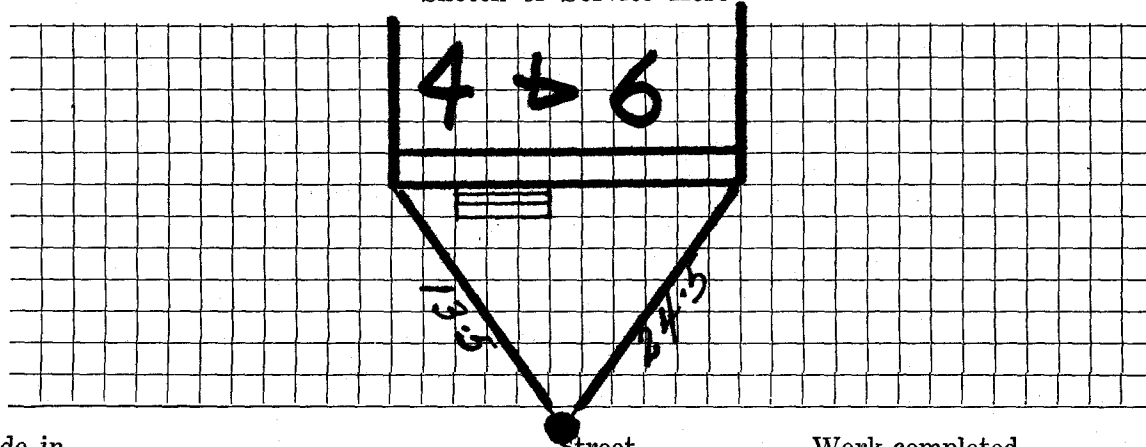

Connection made in _____ Street.

Work completed _____ 19

Remarks: