

Name

15
Service No. 224

Address

Edmund J. Lewis

41 Pleasant St.

Location

41 Pleasant Street #3550

Kind of Pipe

Size of Main

Repair—Renewal—New Service

Location

Comm 10-23-73

Do they are on well water shutoff

5/17/56 Date 1-30-73 11-8-73

Hadley Press, Inc., Lexington

Date	Material				Date	Amount
5/2/73	Labor					400 00
5/3/73	"					4 73
5/4/73	"	18	83			404 73
	10% O.H.	14	80	162		
	148' 1" copper pipe			149		
	3 1" unions @	4	99	14		
	1 1"x3/4" wheel valve			9.70		
	5 yds. loam @	5	00	25		
	5 lbs. grass seed			4		
	4 hours trucking @	3	00	12		
	4 hours town shovel @	6	50	26		
				404		
	Labor			73		
						Bill sent 473
5/15/73	Repaired water service outside					
						retired o/w water service 5/11/73

Deposit Paid

Bill sent 473

TOWN OF LEXINGTON—BOARD OF PUBLIC WORKS

WATER DIVISION

The undersigned applies for a supply of water at No. _____ St. and hereby agrees to comply with the rules and regulations as now, or at any future time, established by the Board of Selectmen.


Am't. of Estimate \$ _____

Am't. Paid \$ _____

Builder _____

*There are on
well water
water off at curb
5/17/96*

*Pauline E. Bartlett
41 Pleasant St.*

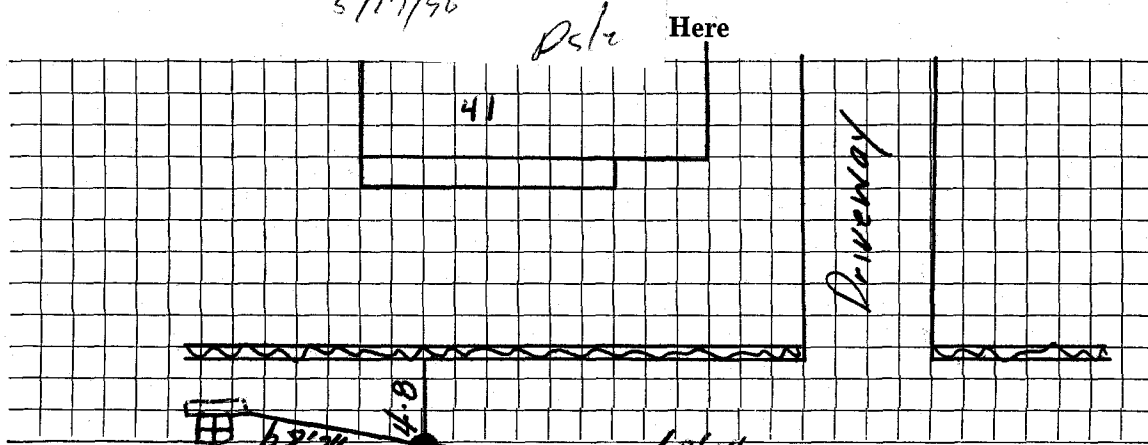

Connection made in _____

Remarks:

Street.

Work completed _____

