

Name Pasquale Luongo

Service No. # 2247

Address 47 Pleasant St.

Location

Kind of Pipe

Size

Size of Main

~~Repair—Renewal—New Service~~

Location

Date	Material	Amount	Total	Date	Amount
Com 30.01	65' 1" Copper Pipe @.24	15 60			
4-26-32	1 1" C.TO C.Union	1 00			
	1 S & W	3 00	19 60		
	Trucking		75		
2-16/32	12 Hrs.Labor @.55	6 60			
	3 " " @.60	1 80	8 40		
	15% Overhead		1 26		
			30 01		
	Labor				

May 6 1932 - Cash

30 01

Hadley Press, Inc., Lexington

DATE _____

TOWN OF LEXINGTON—BOARD OF PUBLIC WORKS

WATER DIVISION

The undersigned applies for a supply of water at No. _____ St. and hereby agrees to comply with the rules and regulations as now, or at any future time, established by the Board of Selectmen.

Am't. of Estimate \$ _____


Owner _____

Am't. Paid \$ _____

Address _____

Builder _____

Sketch of Service Here

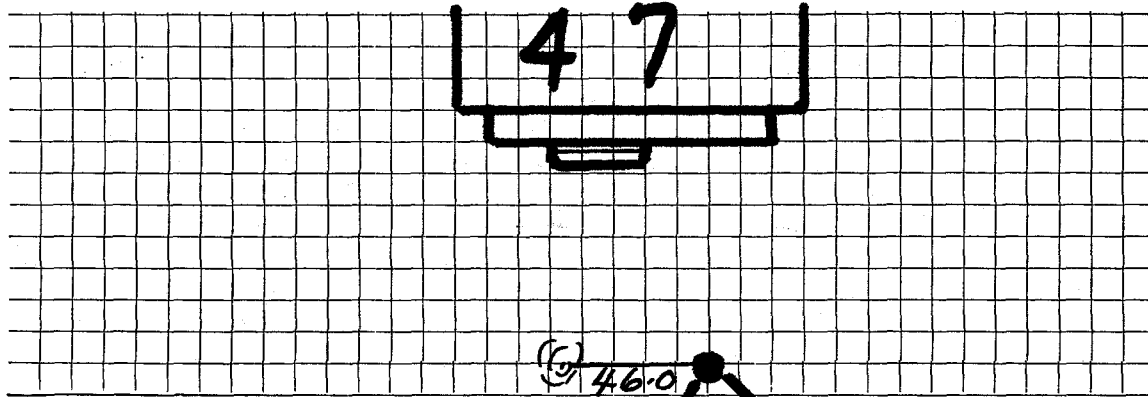

Connection made in _____

Street.

Work completed _____

19

Remarks:

