


DATE _____

TOWN OF LEXINGTON — BOARD OF PUBLIC WORKS

WATER DIVISION

Sketch of Service Here

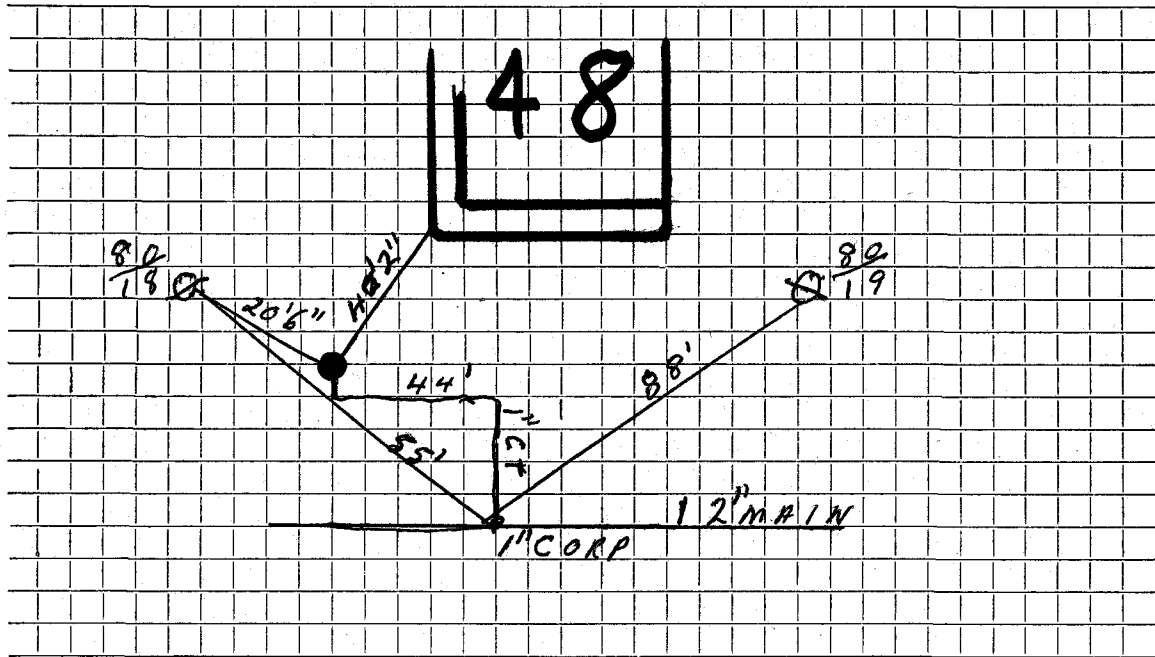

Connection made in Street. Work completed

Remarks: ... *H. H. Pt. 1" COPPER OUTSIDE*

..... *H. S. Pleasant field through house 5. Z. Pleasant*